

REWITNESSED CORNER FOR STATE OF OREGON-DEPARTMENT OF FORESTRY

Closing corner common to Sections 30 and 31, Township 22 South, Range 11 West, W.M., Douglas County, Oregon.

ORIGINAL

18" X 12" X 8" Stone (found in place, 5 notches on North side) from which a:

- 36" Fir stub bears N65°E 45 lks.; now 20" X 24" high stub, in place, burnt and badly decayed, no scribes visible.
- 40" Fir stub bears S45°E 192 lks.; missing, in new slide out draw.
- 36" burnt Fir bears S43°W 193 lks.; missing.
- Spur Ridge bears East 131 lks.; in place.

REWITNESSED


- 45" Fir bears N67°E 5.3 ft. to face; scribed T22S R11W S30 cc BT.
- 27" Fir bears S48°E 49.1 ft. to face; scribed T22S R11W S31 cc BT RS359.

Set 4" X 4" X 72" white painted Cedar post 2.8 ft. N33°W of cornerstone. Oregon State Forestry Department metal location poster on 20" Fir North 20.0 ft.

Dated June 17, 1974.

Restored by William E. Metcalf, Engineer under my direction.

Present and witnessed by Anthony J. Klosterman
James L. Shumway

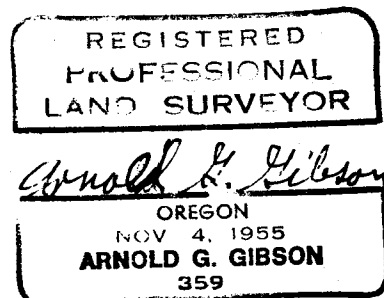

*195 722-11 ✓
*118 722-12 ✓

C. S. File No. 57/4-4 c