

9-5-74

T295

33

5 | 4 R I E

5

T305

CC

FD:

A CONGLOMERATE STONE, FIRMLY SET, OF WHICH THE EXPOSED PORTION MEASURES 14" X 4" X 6" WITH

4 GROOVES AND "R I E S 4" CHISELED ON THE EAST FACE,

"CC" CHISELED ON THE SOUTH FACE;

AND 2 GROOVES AND "T305" CHISELED ON THE WEST FACE.

FROM WHICH;

AN ORIG. 10" NOW 15" D. FIR, LEANING BADLY, BEARS S 47° W 16^E FT., ALIVE AND WELL-HEALED.

#22 T30-1E WE FIND A SMALL GROUND DEPRESSION, BUT NO OTHER TRACE OF THE ORIGINAL SE BEARING TREE.


DIETZGEN NO. 385-6

NEW SE BT 10" SUGAR PINE

58°E

24² LVL

"T305 RIE S4 CC CS BT"

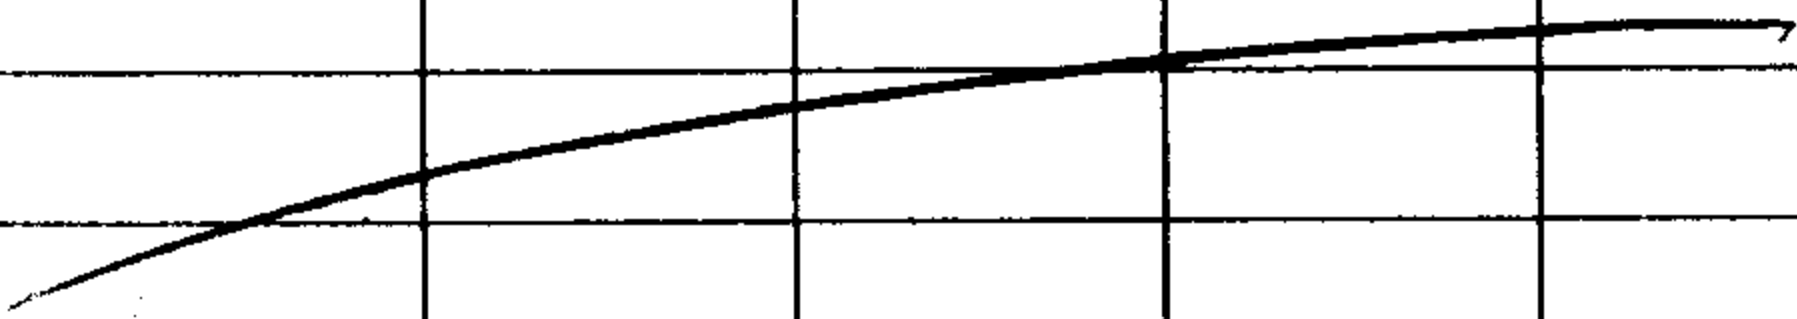

TO NEW SW BT 10" GRAND Fir

585°W

33² LVL

"T305 RIE S5 CC CS BT"



WE LEAVE THE ORIGINAL STONE IN PLACE
AT THE CLOSING CORNER AND MARK THE
FOLLOWING BEARING TREES;

AN 18" SUGAR PINE BEARS S 8° E 24¹/₂ FT.,
SCRIBED "CC T 30 S R 1 E S 4 CS BT"

A 10" GRAND FIR BEARS S 85° W 33²/₉ FT.,
SCRIBED "CC T 30 S R 1 E S 5 CS BT"

COMPASS DECLINATION SETTING AT 20° EAST.

9-5-74

Larry L. Langlet
PETER L. EARLE

OK
[Signature]