

28	27
33	34

T245 R2W

Ed:

ONE BEARING TREE INTACT, A 22" NOW 24'
 HEMLOCK SNAG MARKED BY BLM CREWS IN 1951
 DURING A RESURVEY. THIS AREA HAS
 EXPERIENCED LANDSLIDE ACTIVITY AND AS A
 RESULT, THERE IS NO OTHER EVIDENCE OF THE
 ORIGINAL OR SUBSEQUENT SURVEYS.

WE THEREFORE SET A WITNESS CORNER 85
 FT. SOUTH OF THE TRUE CORNER POINT AS
 DETERMINED FROM THE ONLY REMAINING BT.,
 A 24" HEMLOCK SNAG BEARING $N 9\frac{1}{4}^{\circ} E$
 55 $\frac{1}{2}$ FT., WITH SCRIBING "T245 R2W 327 BT"
 PLAINLY VISIBLE ON AN UNHEALED BLAZE.

AT THE WITNESS CORNER WE SET A 1" X 30"
 IRON PIPE, 28 INCHES IN THE GROUND WITH A
 BRASS CAP ATTACHED, MARKED:

#89 ✓

55² @ 12°

.97815

54²

+ 2
554

42⁰ @ 29°

.87462

36²

50² @ 14 1/2°

.96815

48⁴

85⁴

~~SOUTH~~

NE BT 12" Red Cedar

31¹ @ 13°

.97437

30³

N 35° E

"WC T24S R2W S34 CS BT"

SNW BT 26" Hemlock

42⁵ LVL

N 64° W

WC T24S R2W S33 CS BT

SW BT 18" D Fir

23² LVL

554° W

WC T24S R2W S33 CS BT

COUNTY SURVEYOR'S OFFICE

T24S R2W

S28 | S27

S33 | S34

WITNESS COR.

85 FT. NORTH

TO TRUE COR.

1974

FROM WHICH WE MARK THE FOLLOWING BEARING
TREES FOR THE WITNESS CORNER:

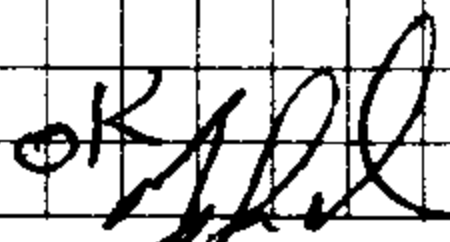
A 12" RED CEDAR BEARS N 35° E 30³/₄ FT.,
SCRIBED "WC T24S R2W S34 CS BT".

A 26" HEMLOCK BEARS N 64° W 42⁵/₈ FT.,
SCRIBED "WC T24S R2W S33 CS BT".

AN 18" D. FIR BEARS S 54° W 23⁹/₈ FT.,
SCRIBED "WC T24S R2W S33 CS BT".

10-14-74

Gary L. Langlet
PETER L. EARLE.

OK U. S. File No. 57/8-12