

12-9-74

$\frac{1}{4}$ 24 T 30S R2W
25

THIS CORNER SET FROM SURVEY OF THE SOUTH LINE OF SECTION 24, ITS LOCATION DETERMINED BY SINGLE PROPORTIONATE MEASUREMENT. AN EXHAUSTIVE SEARCH OF THE AREA YIELDED NO TRACE OF THE ORIGINAL CORNER.

AT THE CORNER POINT WE SET A 1" X 30" IRON PIPE WITH BRASS CAP ATTACHED,

MARKED:

COUNTY SURVEYOR'S OFFICE

T 30S

$\frac{1}{4}$ S 24
S 25

R 2W

1974

FROM WHICH:

A 20' D. FIR BEARS N 51° E 51 $\frac{7}{8}$ FT.,
SCRIBED " $\frac{1}{4}$ S 24 CSET". NOTE: THE
BLAZES ON THIS BT FACE SOUTH.

#187 ✓

DIETZGEN NO. 385-6


74⁴¹ @ 7° .99255

73⁸⁶

48⁵¹

22° .92718

44⁹⁸

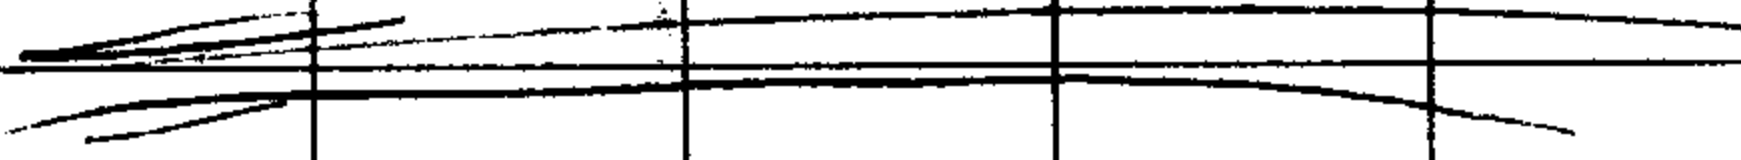

55° @ 20° .93969

51²

20" D. FR 1/4 S 24 CS BT

BLADE FACING SOUTH

N 51° E

24° LUL

10" MADLONE

S 3° W

1/4 S 25 CS BT

AND A 10" MADRONE BEARS S 3° W 24°
FT., SCRIBED "1/4 S 25 CS BT"

COMPASS DECLINATION SETTING: 20° EAST

12-9-74

Gary L. Doughty
PETER L. EARLE

[Handwritten signature]

DIETZGEN NO. 385-6

11-13-74

$\frac{1}{4}$ $\frac{24}{25}$

T30S R2W

THIS CORNER SET FROM SURVEY OF SOUTH LINE OF SECTION 24 BY SINGLE PROPORTIONATE MEASUREMENT. A PRIOR SEARCH OF THE AREA YIELDED NO TRACE OF THE ORIGINAL CORNER.

AT THE CORNER POINT WE SET A 1" X 30" IRON PIPE WITH BRASS CAP ATTACHED, MARKED.

COUNTY SURVEYORS OFFICE

T30S

$\frac{1}{4}$ $\frac{24}{25}$

R2W

1974

FROM WHICH WE MARK THE FOLLOWING BEARING TREES;

A 20' D. FIE BEARS N 6° E 10 2/3 FT.,

SCRIBED " $\frac{1}{4}$ S 24 CS BT"

DIETZEN NO. 385-6

VOID

~~101 S4 CLINO @ 1/6" 96125 = 97.61~~

$\tan 2788 = 15^\circ 25' = 0.2702$
= 101 25 SLOPE

NE BT 20" D. Fir N 6° E

10 2 LVL


" 1/4 S2A CSBT "

58"

SE BT 6" D. Fir S 40° E

21 8 LVL

1/4 S2A CSBT

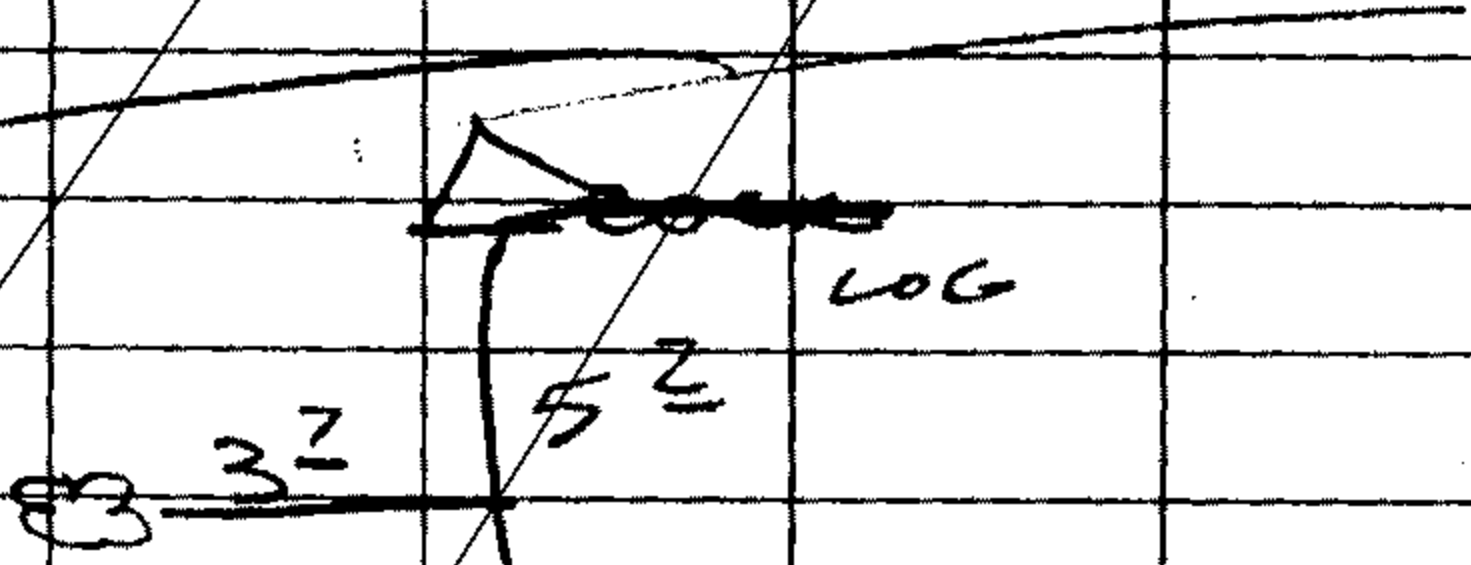

AND A 6" D. FR BEARS S 40° E 21⁰ FT.,
SCRIBED " 1/4 S 25 CS BY "

COMPASS DECLINATION SETTING: 20° EAST

11-13-74

Gary R. Langley
PETER L. EARLE

VOID

DIETZGEN NO. 385-B