

1-3-75

COR. # 19

H.E.S. # 179 T 295 R 1 E

(SEE REN. # 16)

Fd:

A 40" NOW 42" D. FIR BEARING TREE
MARKED BY COUNTY SURVEYOR'S OFFICE
CREWS IN 1969, SCRIBING VISIBLE.

DUE TO CHANGES IN THE COURSE OF
THE SOUTH UMPQUA RIVER, THE ORIGINAL
CORNER AND WITNESS CORNER SET
IN 1969 HAVE BEEN DESTROYED EXCEPT
FOR THE AFOREMENTIONED BEARING TREE.

WE NOW SET A NEW WITNESS CORNER
BEARING N 54° W 188⁰ FT. FROM THE
TRUE CORNER. AT THE WITNESS CORNER,
WE SET A 1" IRON PIPE, 30 INCHES LONG,
27" IN THE GROUND, WITH BRASS CAP ATTACHED.

MARKED:

#91 ✓

C.S. File No. 57/17-1 PAGE 1 C

WC 19 HES 179 CSBT

24 " IN. CEDAR S 17½° W
91 ± LVL

APPROX 100 ± FT LT

26 " D. Fir N 59° E

" WC 19 HES 179 CSBT
98 ± LVL

APPROX 30 SOUTHERLY

37 " RED CEDAR N 3½° W
89 ± LVL

WC 19 HES 179 CSBT

APPROX 20' NTH' LT

COUNTY SURVEYOR'S OFFICE

T 29 S R 1 E

COR. 19

H. E. S. 179

WIT. COR.

S 54 E 188 FT.

1975

WE LEAVE THE AFOREMENTIONED BEARING TREE INTACT AND MAKE NO REFERENCE TO IT CONCERNING THE WITNESS CORNER NOW BEING SET.

WE MARK THE FOLLOWING BEARING TREES FOR THE WITNESS CORNER;

A 24" INCENSE CEDAR BEARS
S $17\frac{1}{2}^{\circ}$ W 91 $\frac{2}{3}$ FT., SCRIBED
"WC 19 HES 179 CS BT"

THIS TREE STANDS APPROX 100 FT.
SOUTHERLY OF SOUTH UMOQUA ROAD

C 50

T23 = R1E

COR 19

H.E.S. 179

WIT COR.

S54^W E 188 FT,

1975

APPROX 30' SOUTHERLY

A 26" D. FIR BEARS N 59° E 98¹/₂ FT.,
SCRIBED "WC 19 HES 179 CSBT"

THIS TREE STANDS APPROX. 30 FT.

SOUTHERLY OF SOUTH UMQUA ROAD.

A 37" RED CEDAR BEARS N 3¹/₂° W 89¹/₂ FT.,

SCRIBED "WC 19 HES 179 CSBT"

THIS TREE STANDS APPROX. 20 FT.

NORTHERLY OF SOUTH UMQUA ROAD.


NOTE:

THIS WITNESS CORNER LIES ON THE
FLAT APPROX. 30 FT. SOUTHERLY
OF SOUTH UMQUA ROAD.

1-3-75

Gary E. Commons
GARY E. COMMONS
JOHN NORDLING

J. K. [Signature]

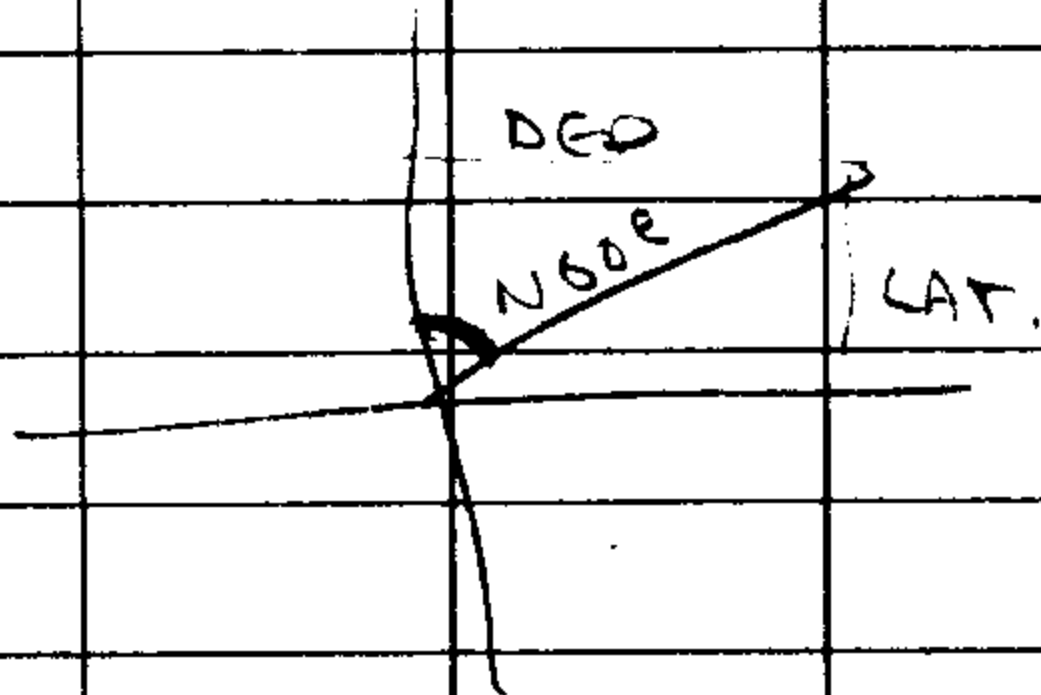

110.1

 151.9

172482

COTAN

N 54°04' W

12122.
 23073.6

 35195.6

180

190

~~187.6~~

187.6