

$\frac{5}{8}$  —  $\frac{1}{4}$  T225 R9W

Fo:

REMAINS OF BOTH ORIGINAL BEARING TREES;

AN ORIGINAL 48" FIR NOW A 50" ROTTEN STUMP WHICH SHOWS A GOOD SCAR ON THE BARK;

AND AN ORIGINAL 32" FIR, NOW A 36" ROTTEN STUMP, PREVIOUSLY OPENED BUT SCRIBING VISIBLE THEN HAS NOW DETECIORATED. WE OPEN HIGHER AND FIND GOOD SCRIBING "1/4".

AT THE CORNER POINT AS DETERMINED FROM THE REMAINS OF THE ORIGINAL BEARING TREES;

A 50" FIR STUMP BEARING N 52° E 40 $\frac{3}{4}$  FT.,

AND A 36" FIR STUMP BEARING S 7° W 15 $\frac{3}{4}$  FT.,  
(RECORDED S 1° W 15 $\frac{3}{4}$  FT.)

#752 ✓


8 " D. Fir

N 45° W

38<sup>G</sup> @ 27° .3710

34<sup>A</sup>

1/4 S 5 CS BT

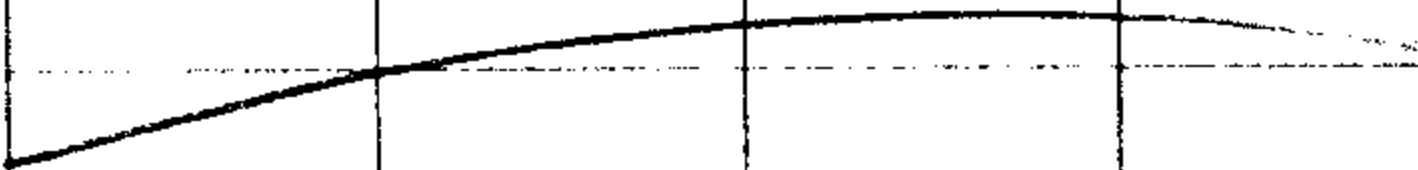

18' D. Fir

S 74° W

23<sup>A</sup> LUL

1/4 S 8 CS BT

18' E 2<sup>M</sup>

WE SET A 1" X 30" IRON PIPE WITH  
BRASS CAP ATTACHED, MARKED:

COUNTY SURVEYOR'S OFFICE

T 22 S

S 5

S 8

R 9 W

1975

FROM WHICH WE MARK THE FOLLOWING NEW  
BEARING TREES,

AN 8" D. FIR BEARS N 45° W 34<sup>±</sup> FT.,  
SCRIBED " 1/4 S 5 CS BT "

AN 18" D. FIR BEARS S 74° W 23<sup>±</sup> FT.,  
SCRIBED " 1/4 S 8 CS BT " .

COMPASS DECLINATION SETTING: 20° EAST

2-6-75

Larry J. Langlotz

VIC LARGIE

J. S. File No. 5717-16

*[Signature]*