


Section 12 Twp 22S Rge 8 W

Date: 4-16-75

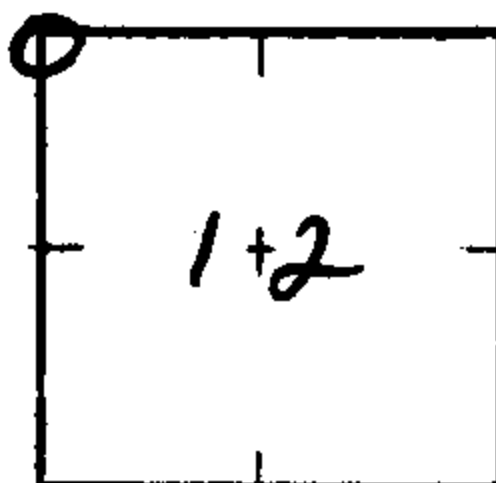

How was corner identified? Found Cadastral B.C. & 4 B.T's

Condition of corner: good

Best route to reach corner: E from Rd 22-8-10.0

Quadrant	NE	NW	SE	SW
Species & Size	8" D	12" H	4" D	8" H
Dist. & Bearing	S 9W, 62 lks	S 22E, 56 lks	N 16W, 139 lks	N 21E, 16 lks
Condition of Scribe				
Original or Resurvey				
Appearance of B.T.	good	good	good	good
Tags, Marks, etc.	tag	tag	tag	tag

Other Remarks:

at corner of proposed clearcut unit (B.C.M.)

W. Steven Cole
Forester, Woolley Ent.

Signed

CS 57/21-7