

SE COR.

DLC 41 T30S R5W 1/4 Sec. 7

(SEE REN. # 145)

FD:

BRASS DISK SET AND MARKED AS DESCRIBED
IN REN. # 145. THE OAK BT MENTIONED IN
 REN. # 145 HAS BEEN DESTROYED.

WE NOTE THE FOLLOWING BEARING OBJECTS
 FOR THE DLC CORNER:


A "PK" NAIL DRIVEN IN A CONCRETE RETAINING
 WALL AT THE A&W DRIVE IN, APPROX 3 FT.
 ABOVE GROUND LEVEL BEARS $S 27^{\circ} E 121$ ⁵⁴
 FT.

A 1" I. PIPE FOUND IN THE STATE HIGHWAY
 R/W FENCE NEAR STATION POC 227+40
 385 FT EAST OF THE CENTERLINE OF
 INTERSTATE HWY 5 BEARS $S 79^{\circ} E$
 84 ⁵⁰ FT.

SEE ACCOMPANYING SKETCH.

DIETZEN NO. 385-6

SE COR
DLC 41
T30S25W

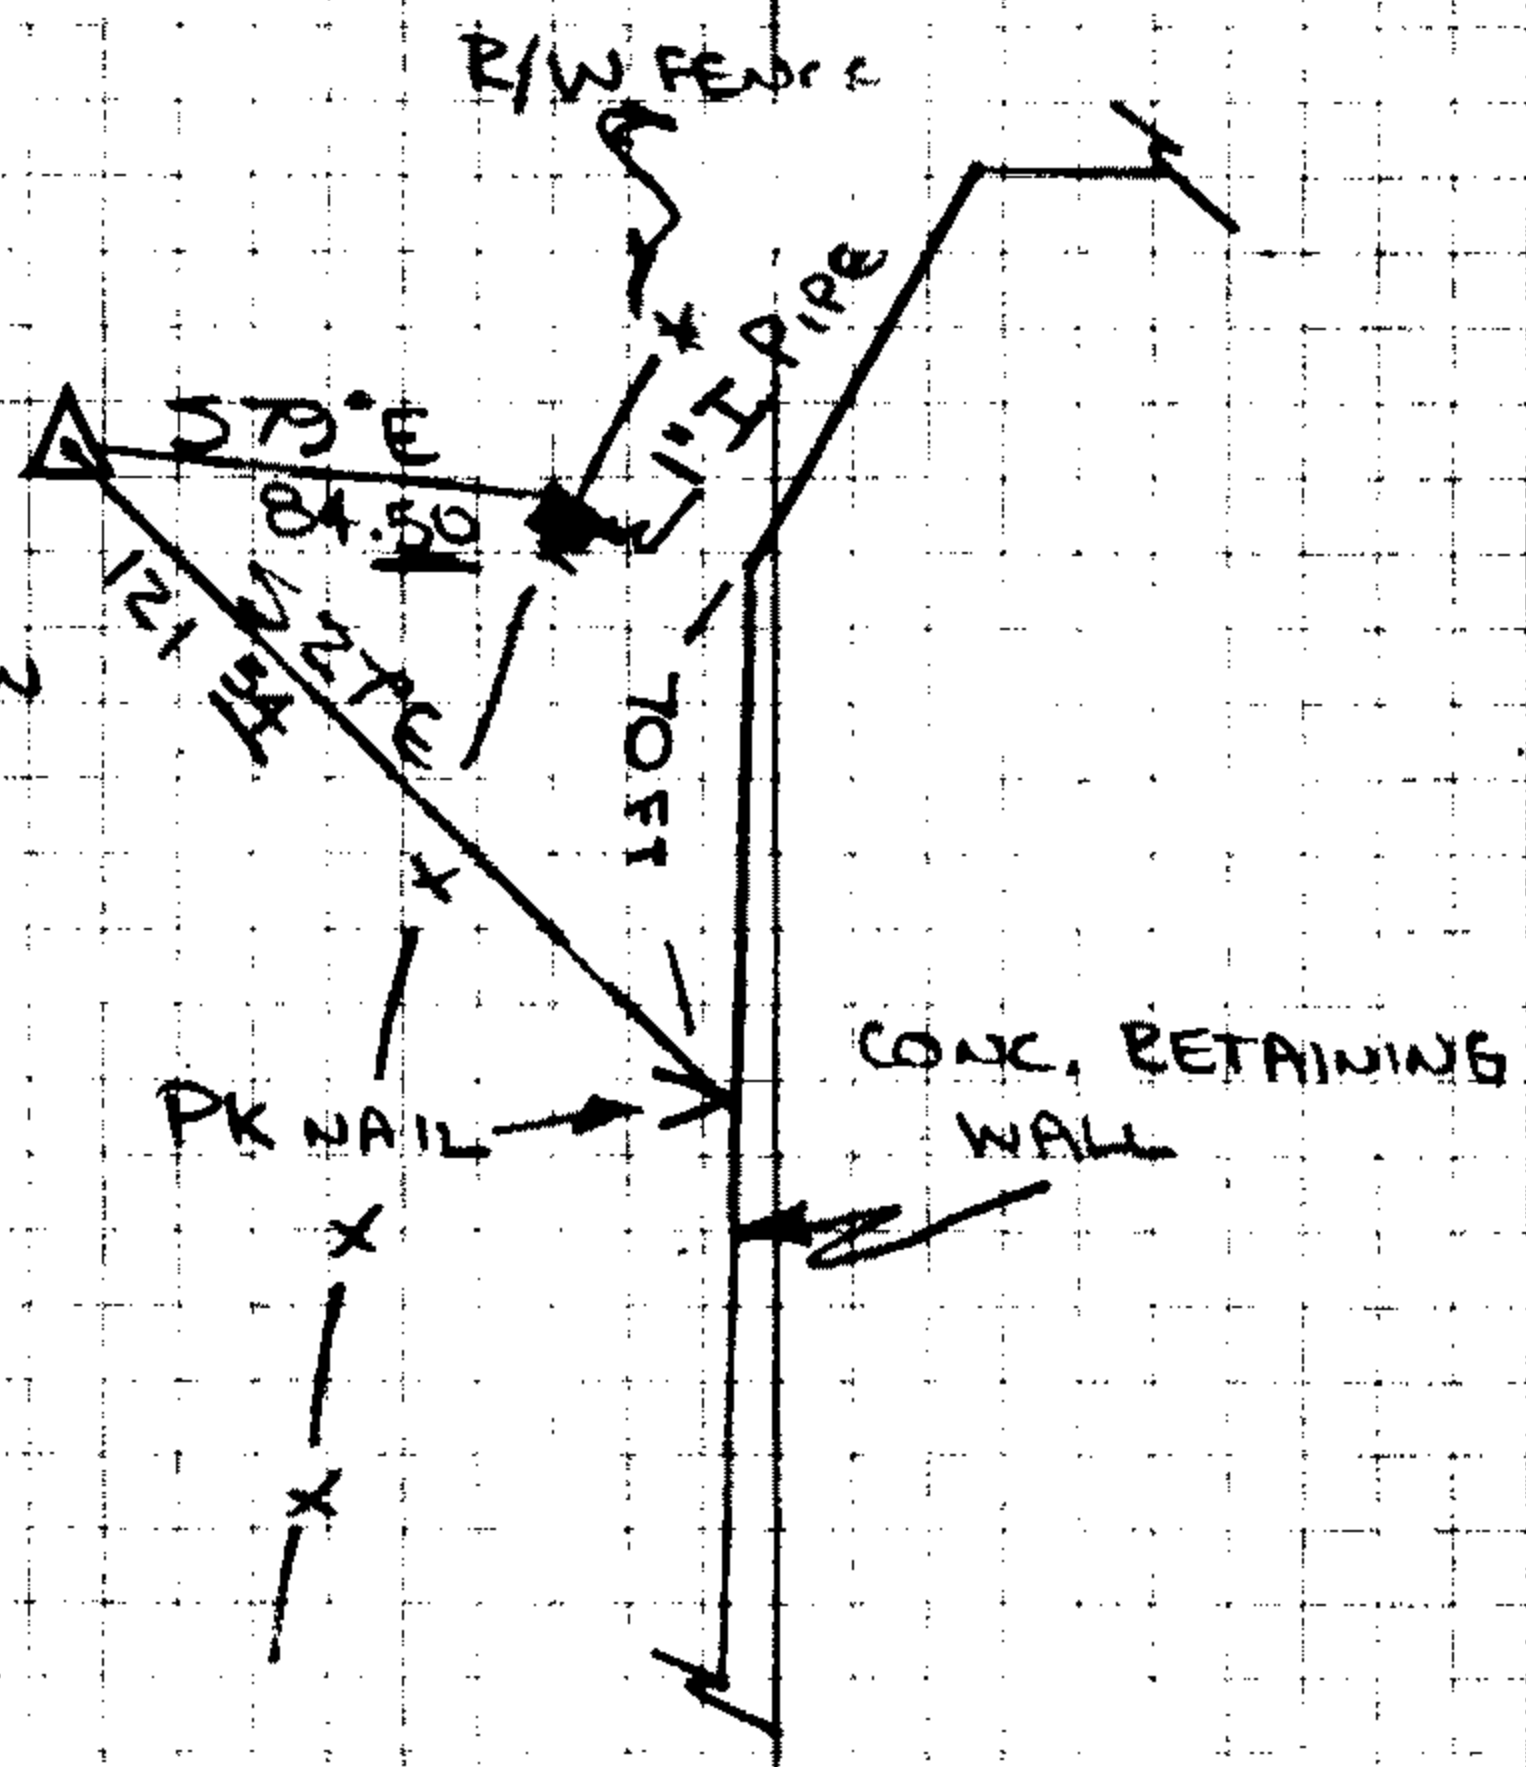

5-22-75

OK
[Signature]

Harry J. Knight
C. L. E. GORWIN
M. LENOVA LADIG

262

G. S. File No. 57/30-2