


6-4-75

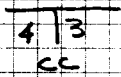


T295 RIW

Fd1

A 2" I Pipe, LEANING SLIGHTLY BUT FIRM IN THE GROUND, WITH BRASS CAP ATTACHED, MARKED:

U.S. GENERAL LAND OFFICE SURVEY

T285 RIW 533

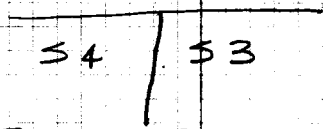

T295 RIW

CC

1922

FROM WHICH:

AN ORIG. 10" NOW 22" SUGAR PINE BEARS  
S 39° E 4 <sup>5</sup>/<sub>8</sub>, ALIVE AND WELL-HEALED

AND AN ORIG. 6" CHINQUAPIN, NOW A 7" ROTTEN  
SNAG BEARS S 42° W 14 <sup>5</sup>/<sub>8</sub> FT, WITH SOME  
ILLEGIBLE SCRIBING REMAINING ON A WELL  
ROTTED, UNHEALED FACE.

#113/241  
~~#204/251~~

DIETZGEN NO. 1885-B

WE MARK A NEW BEARING TREE AS FOLLOWS

A 9" GRAND FIR BEARS S 37° W 5<sup>3</sup> FT.,  
SCRIBED "T295 R1W S4 CC CSBT" ON  
A DOUBLE BLAZE.

COMPASS DECLINATION SETTING: 20° EAST

6-4-75

Gary D. Langley

CLIFF E. GOODWIN

M. LINDA LADIG.

OK  
*[Signature]*

DIETZEN NO. 1898