

6-5-75

$\frac{1}{4}$   $\frac{29}{32}$  T275 RIW

Fd:

A STONE, APPROX 8" X 9" X 12", APPROX. 4" IN  
THE GROUND & LOOSE, WITH A FAINT "1/4" MARKED  
ON THE APPARENT NORTH FACE.

WE FIND NO EVIDENCE OF ANY CORNER  
ACCESSORIES. THE AREA ADJACENT TO  
THIS CORNER HAS BEEN LOGGED AND  
BURNED.

WE DO NOT MONUMENT THE CORNER AT  
THIS TIME.

6-5-75

Henry L. Langley

CLELL E. GOODWIN

A. V. CANGIE

M. LENORA LACIG.

OK  
Jill

#130v

C. S. File No. 57/30-5

RECOVERY NOTES


PROPERTY CORNER INVESTIGATION

LOCATION

T. 275 R. 1W

Mer. Will State Ore

Forest unp Dist. Slide

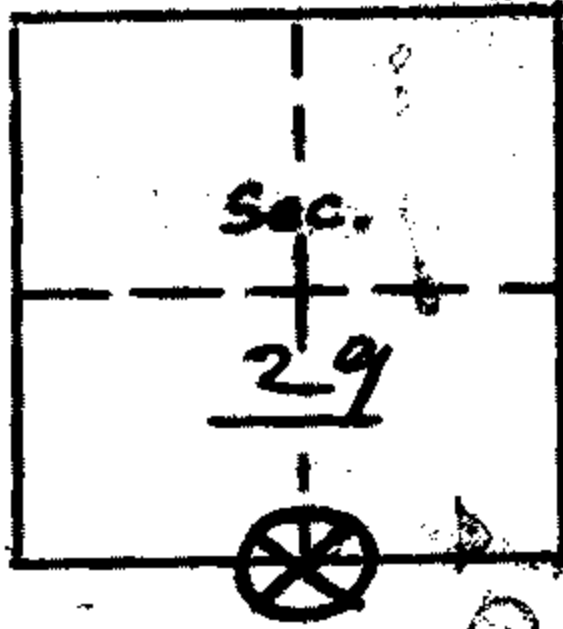

LEGEND

- Corner searched-no evidence
- Corner or accessory found
- Corner marked by perm. mon.

DESCRIPTION OF FOUND CORNER

MATERIAL: Stone SIZE: 8" x 6" x 12"

HEIGHT ABOVE GROUND: 6" CONDITION: Poor

MARKINGS: 1/4 on N face.

DESCRIPTION OF FOUND ACCESSORIES

NO recognizable bearing trees found. - corner is on edge on existing clearcut & 100' west of rd # 2794

NOTE: Indicate full investigative details on back of form.

PHOTO IDENTIFICATION

Symbol & date \_\_\_\_\_ Line or Roll \_\_\_\_\_ Exposure \_\_\_\_\_

How Identified Field Where filed Slide

RECOVERED BY: JBJ

DATE: 9-17-73 TITLE: \_\_\_\_\_

69-82-11 JMJ/JP 11-28-69

Corner needs re monumenting

Put location post  
on stump, N 50° E, 90'  
from stone.