

(UNOFFICIAL - SURVEY PENDING)

T. 25 S., R. 7 W.

1/4 SEC. COR. BET. SECS. 2 & 35 (S. BDY.)


FD.

B. OAK SNAG, 37" N 89 3/4° W 792 LKS. SCRIBE MARK T VIS.

" " " 38" S 89 3/4° W 806 LKS. SCRIBE MARKS 4 SBT

SET

2 1/2" IP 18" IN GRD, IN M.S. 4' base to top, w/B.C. MKD.

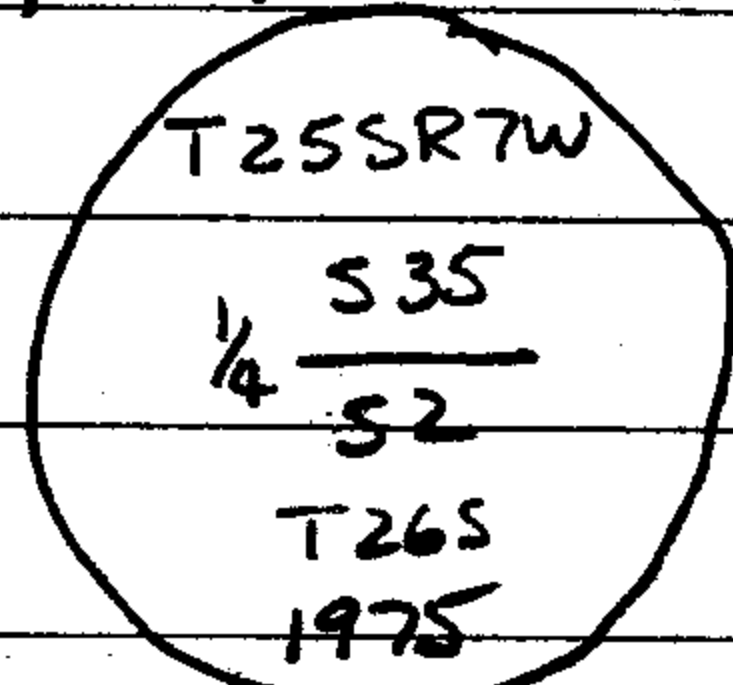

# 09-T25-1  
# 102-T26-1

SANDSTONE BOULDER 4' x 4' IN PLACE N 35° W 85 1/2 LKS. X BO

34 | 35


3 | 2

FD. - B. OAK, 59" N 89° W 1196 LKS, BT VIS.

- Root hole N 40° E 708 LKS.

SET 2 1/2" IP 28" LONG w/TOP 6" below surface

B.C. MKD.

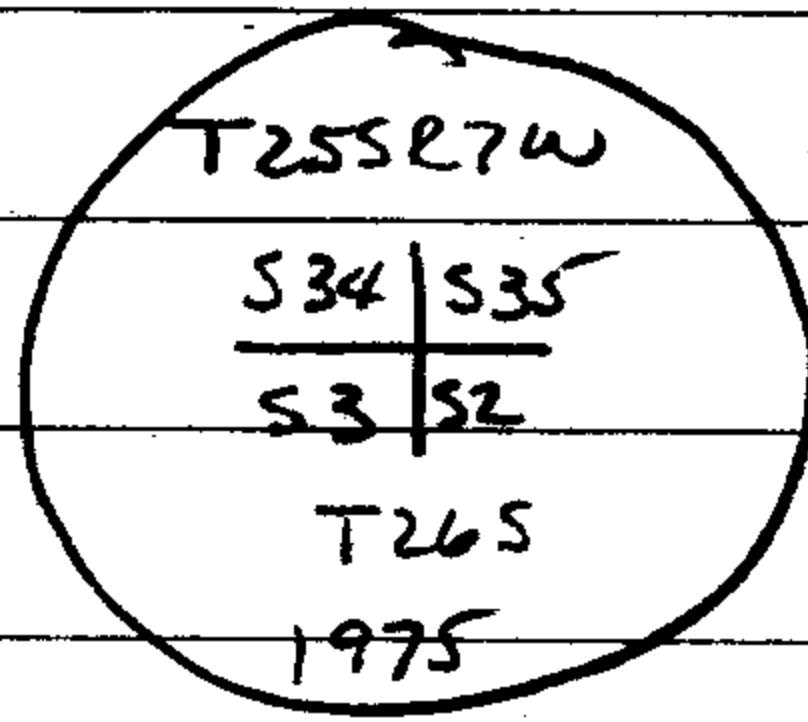

NEW BT'S

A FIR, 12" S 80° W 1011 LKS. T26SR7W S3 BT.

A FIR, 20" N 65 1/2° E 553 LKS. T25SR7W S35 BT.

27 | 26

34 | 35

FD. DECAYED OAK STUMP (?) N 65° E 42 LKS.

" " " (?) S 47° W 121 LKS.

B. OAK 38" N 20° W 51 LKS. FRAG. SCRIBING