

7-22-75

$\frac{1}{4}$ 15
4 22

T26S R1W

(SEE REN. # 18)

FD:

A STONE, 12" X 8" X 6", WITH A " $\frac{1}{4}$ " MARKED ON THE NORTH FACE, FIRMLY SET,

FROM WHICH:

A 4" NOW 6" HEMLOCK MARKED IN 1967 BY SHANER BEARS S 5° E 3.4 FT., ALIVE WITH SCRIBE MARKS VISIBLE

SHANER'S NE BEARING TREE WAS KNOCKED OVER BY LOGGING OPERATIONS.

AT THE CORNER POINT, WE SET A 1" X 30" IRON PIPE WITH BRASS CAP ATTACHED, MARKED:

DOUGLAS CO. SURVEYOR

T 26S

$\frac{1}{4}$ 315
522

R1W

70C
C. S. File No. ~~57/34-6~~ 1975

CIEPZSEN NO. 389-6

WE PLACE THE CORNERSTONE ALONGSIDE
THE BRASS CAP AND MARK THE FOLLOWING
BEARING TREE:

AN 8' CHINQUAPIN BEARS N 71° W 75 FT.
SCRIBED: "1/4 S15 CS BT" ON A
DOUBLE BLAZE.

COMPASS DECLINATION SETTING: 20° EAST

7-22-75

Gary L. Langitz

CLELL E. GOODWIN

A. VIC CANGIE

M. LENORA LADIG

OK
JL

C. S. File No. 57/34-6

RECOVERY NOTES


PROPERTY CORNER INVESTIGATION

LOCATION

T. 26S R. 1W

Mer. Will State Ore

Forest Ump Dist. Glide

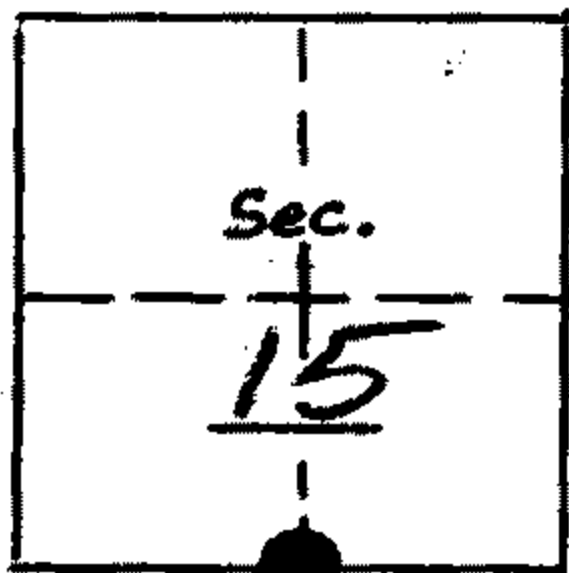

22


LEGEND

- Corner searched-no evidence
- ⊗ Corner or accessory found
- Corner marked by perm. mon.

DESCRIPTION OF FOUND CORNER

MATERIAL: Conglomerate Stone SIZE: 12x8x6"
 HEIGHT ABOVE GROUND: 6" CONDITION: Good
 MARKINGS: 1/4 on North Face

DESCRIPTION OF FOUND ACCESSORIES

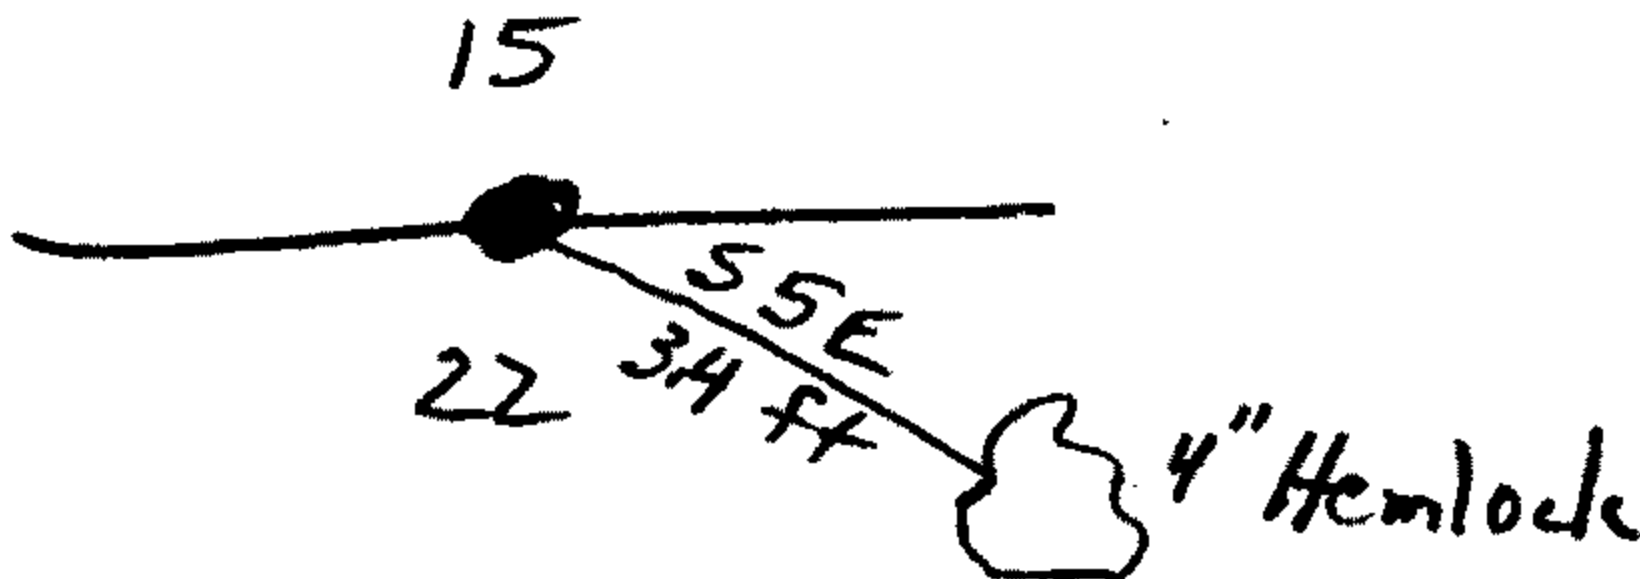

NOTE: Indicate full investigative details on back of form.

PHOTO IDENTIFICATION

Symbol & date _____ Line or Roll _____ Exposure _____
 How Identified _____ Where filed _____

RECOVERED BY: Chuck Young

DATE: 3-27-74

TITLE: Civil. Eng. Tech