

21/22  
28/27

TZ65 RIW

Fd:

A STONE, 10" X 8" X 6", (REC. 15" X 10" X 8"), FIRMLY SET, MARKED WITH 3 NOTCHES ON THE EAST EDGE AND 2 NOTCHES ON THE SOUTH EDGE,

FROM WHICH:

AN ORIG. 20" NOW 24" FIR BEARS  
N 23° E 11 $\frac{1}{2}$  FT., ALIVE AND WELL-HEALED.

THE ORIGINAL SE BEARING TREE HAS BEEN DESTROYED BY LOGGING.

AN ORIG. 15" FIR, NOW AN 18" SNAG BEARS  
S 60° W 23 $\frac{1}{2}$  FT., WITH SCRIBE MARKS  
VISIBLE ON A PARTIALLY HEALED BLAZE.

AND AN ORIG. 8" NOW 15" HEMLOCK BEARS  
N 83° W 23 $\frac{8}{8}$  FT., ALIVE WITH SCRIBE MARKS  
VISIBLE ON A PARTIALLY HEALED BLAZE.

#6 C  
C.S. File No. 57/34-7

AT THE CORNER POINT, WE SET A 1" X 30' IRON  
PIPE WITH BRASS CAP ATTACHED, MARKED:

DOUGLAS CO. SURVEYOR

TZ65

S21	S22
S28	S27

RIW

1975

WE PLACE THE ORIG. CORNER STONE ALONGSIDE  
THE BRASS CAP AND MARK THE FOLLOWING NEW  
BEARING TREE:

A 8" HEMLOCK BEARS S41°E 109<sup>1</sup>/<sub>2</sub> FT.  
SCRIBED: "TZ65 RIW S27 CSBT" ON A  
DOUBLE BLAZE

COMPASS DECLINATION SETTING: 20° EAST

7-22-75

Gary L. Langitz  
CLELL E. GOODWIN

OK  
[Signature]

G. S. File No. 57/34-7

A. VIC CANGIE  
M. LENORA LADIG

RECOVERY NOTES


PROPERTY CORNER INVESTIGATION

LOCATION

T. 26 S R. 1 W

Mer. Will State Oregon

Forest Ump Dist. Glide

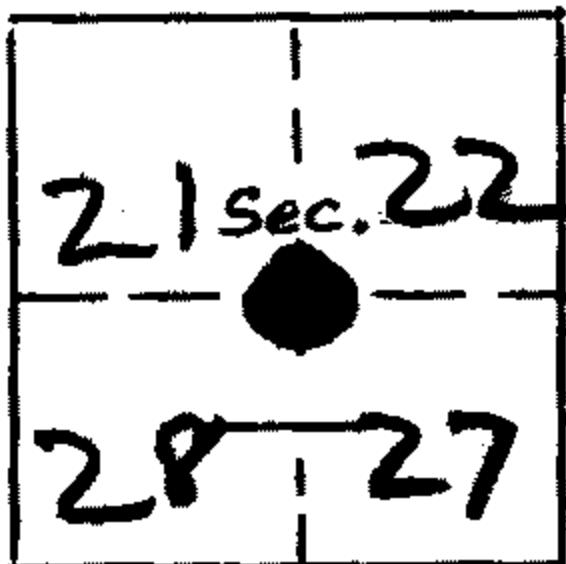

LEGEND

- Corner searched-no evidence
- Corner or accessory found
- Corner marked by perm. mon.


DESCRIPTION OF FOUND CORNER

MATERIAL: Basalt Stone SIZE: 15" x 10" x 8"

HEIGHT ABOVE GROUND: 10" CONDITION: Good

MARKINGS: 3 notches on S, 3 notches on E

DESCRIPTION OF FOUND ACCESSORIES

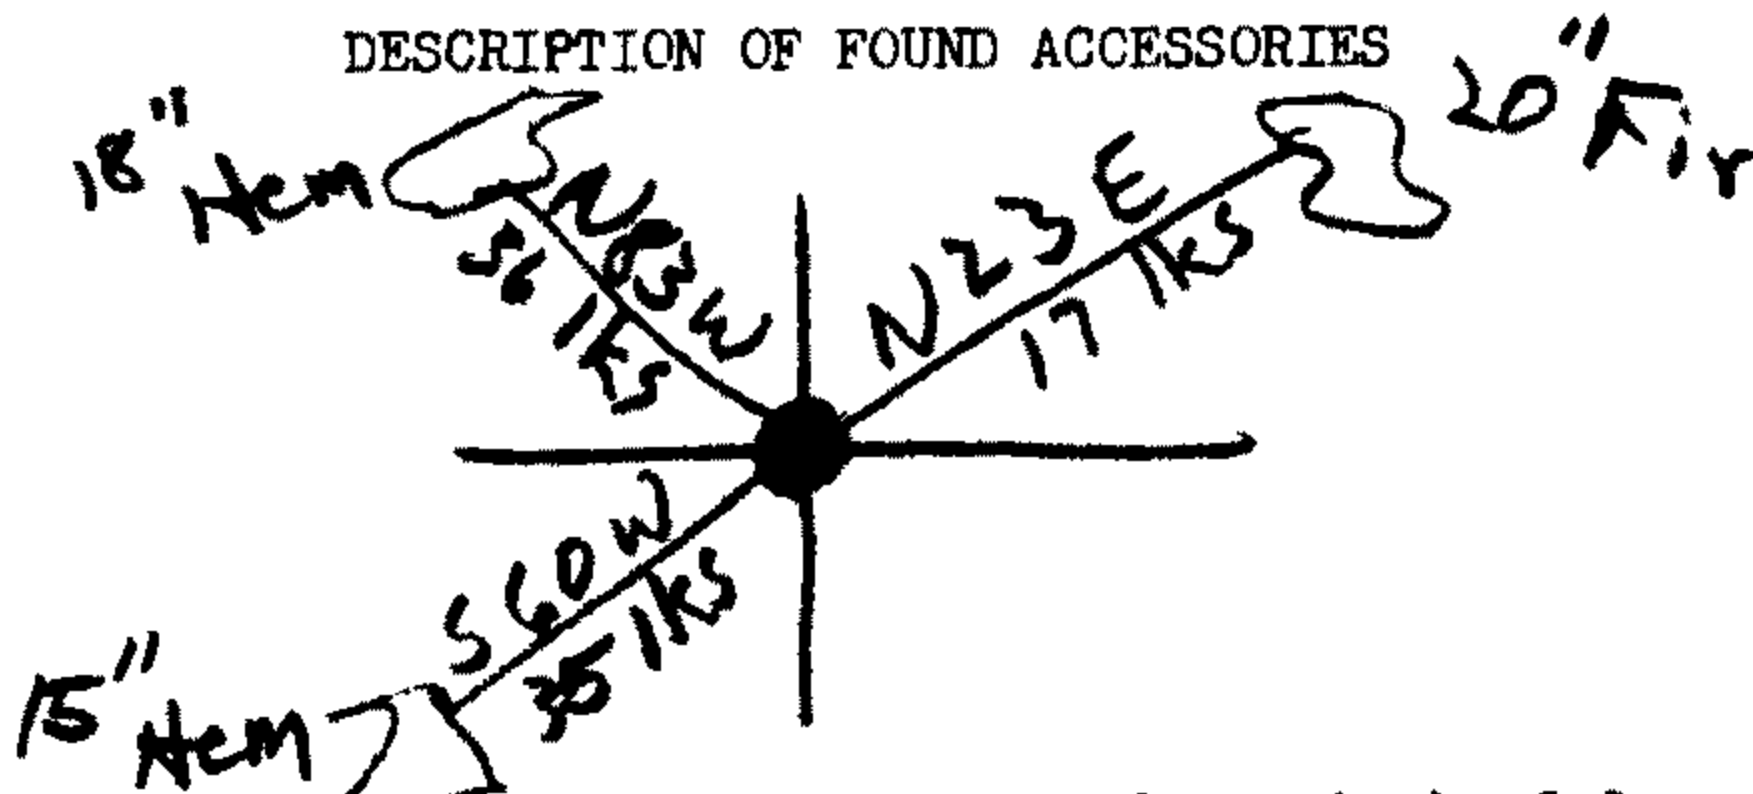

NOTE: Indicate full investigative details on back of form.

PHOTO IDENTIFICATION

Symbol & date \_\_\_\_\_ Line or Roll \_\_\_\_\_ Exposure \_\_\_\_\_

How Identified \_\_\_\_\_ Where filed \_\_\_\_\_

RECOVERED BY: Chuck Young

DATE: 3-27-74

TITLE: Civil Eng Tech