

9-2-75

REN. # 27

FO:

AN IRON PIPE, FIRMLY SET, WITH BRASS
CAP ATTACHED, MARKED:

COUNTY SURVEYOR'S OFFICE

T275

523 / 524

526 / 525

R3W

NOTE:

THE SECTION LOCATIONS SHOWN ON THE
BRASS CAP ARE CORRECT, HOWEVER, THE
CAP IS STAMPED TO BE READ FROM THE NORTH
SIDE.

THE ORIGINAL BEARING TREES ARE ALL DOWN AND
IN VARIOUS STAGES OF DECAY.

WE FIND MILD GODFREY'S TREES MARKED IN 1947
AS FOLLOWS:

A HEMLOCK BEARING APPROX. S 10° W 10³/₄ FT.,
IS DOWN, SCRIBE BURIED.

DIETZGEN NO. 385-6

122

282

5136-2

PAGE 1

7" Hemlock

15⁴ LVL

N84W

" T27S R3W S23 CS BT "

DOUBLE BLAZE

27" D. Fir

S 1/2° E

64³ @ 35°

.8192

52⁸

" T27S R3W S26 CS BT "

DOUBLE BLAZE

.8192

64.5

40960

32768

49152

5283840

AND A HEMLOCK BEARING APPROX. $S 85^{\circ} E$
 $23 \frac{3}{4}$ FT, IS DOWN WITH SCRIBE MARKS
 VISIBLE.

WE MARK THE FOLLOWING NEW BEARING
 TREES:

A 7" HEMLOCK BEARS $N 84^{\circ} W$ $15 \frac{1}{4}$ FT.,
 SCRIBED: "T ZTS R3W S Z3 CS BT" ON
 A DOUBLE BLAZE.

AND A 27" D. FIR BEARS $S 2^{\circ} E$ $52 \frac{3}{8}$ FT.,
 SCRIBED "T ZTS R3W S Z5 CS BT" ON
 A SINGLE BLAZE.

NO OTHER TREES NEAR.

COMPASS DECLINATION SETTING | 20° EAST

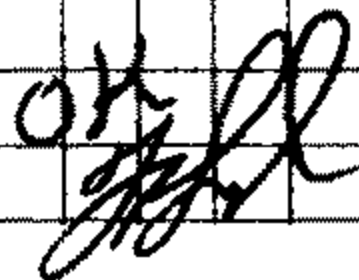
9-2-75

Gary L. Langlet

A. VIC CANGIE

M. LENORA LADIG

MARIE GARRIOTT

OK


File # 57/36-2