

1/4 COR. $\frac{13}{24}$ T.27S., R.7W.

(SEE RENEWAL #98)

AT THE COR. POINT I FIND
BRASS CAP MARKED:

COUNTY SURVEYORS OFFICE

1/4 $\frac{S 13}{S 24}$ T27S R7W

1960

6" NOW 9" N. OAK WHICH BEARS
N 36° W 308.2 FT, ALIVE WITH
WELL HEALED BLAZES.

24" NOW 30" W. OAK WHICH
BEARS S 89 1/2° E 381.2 FT, ALIVE
WITH WELL HEALED BLAZES.

I THEN RESET SAID
BRASS CAP IN A 4" x 36"
BELL TILE, 12" BELOW
SURFACE OF GROUND AND
STAMP "1975" ON CAP.

#183

(OVER) G.S. File No. ~~57/36-~~
17

I THEN SET TWO
BRASS CAPS IN BELL
TILES FLUSH WITH GROUND
ALONG FENCE SOUTH
OF THE COR. POINT.

R.M. 1 BEARS $S 23^{\circ} E$
162.32' AND IS STAMPED:
COUNTY SURVEYOR'S OFFICE

R.M. 1
 $\frac{1}{4}$ \nearrow S 13 T 27 S
S 24 R 7 W
1975

R.M. 2 BEARS $S 51\frac{1}{2}^{\circ} W$
228.80' AND IS STAMPED:

DIETZGEN NO. 385-5

COUNTY SURVEYORS' OFFICE


R.M. 2

1/4

S 13
S 24

T. 27 S.
R. 7 W.

1975

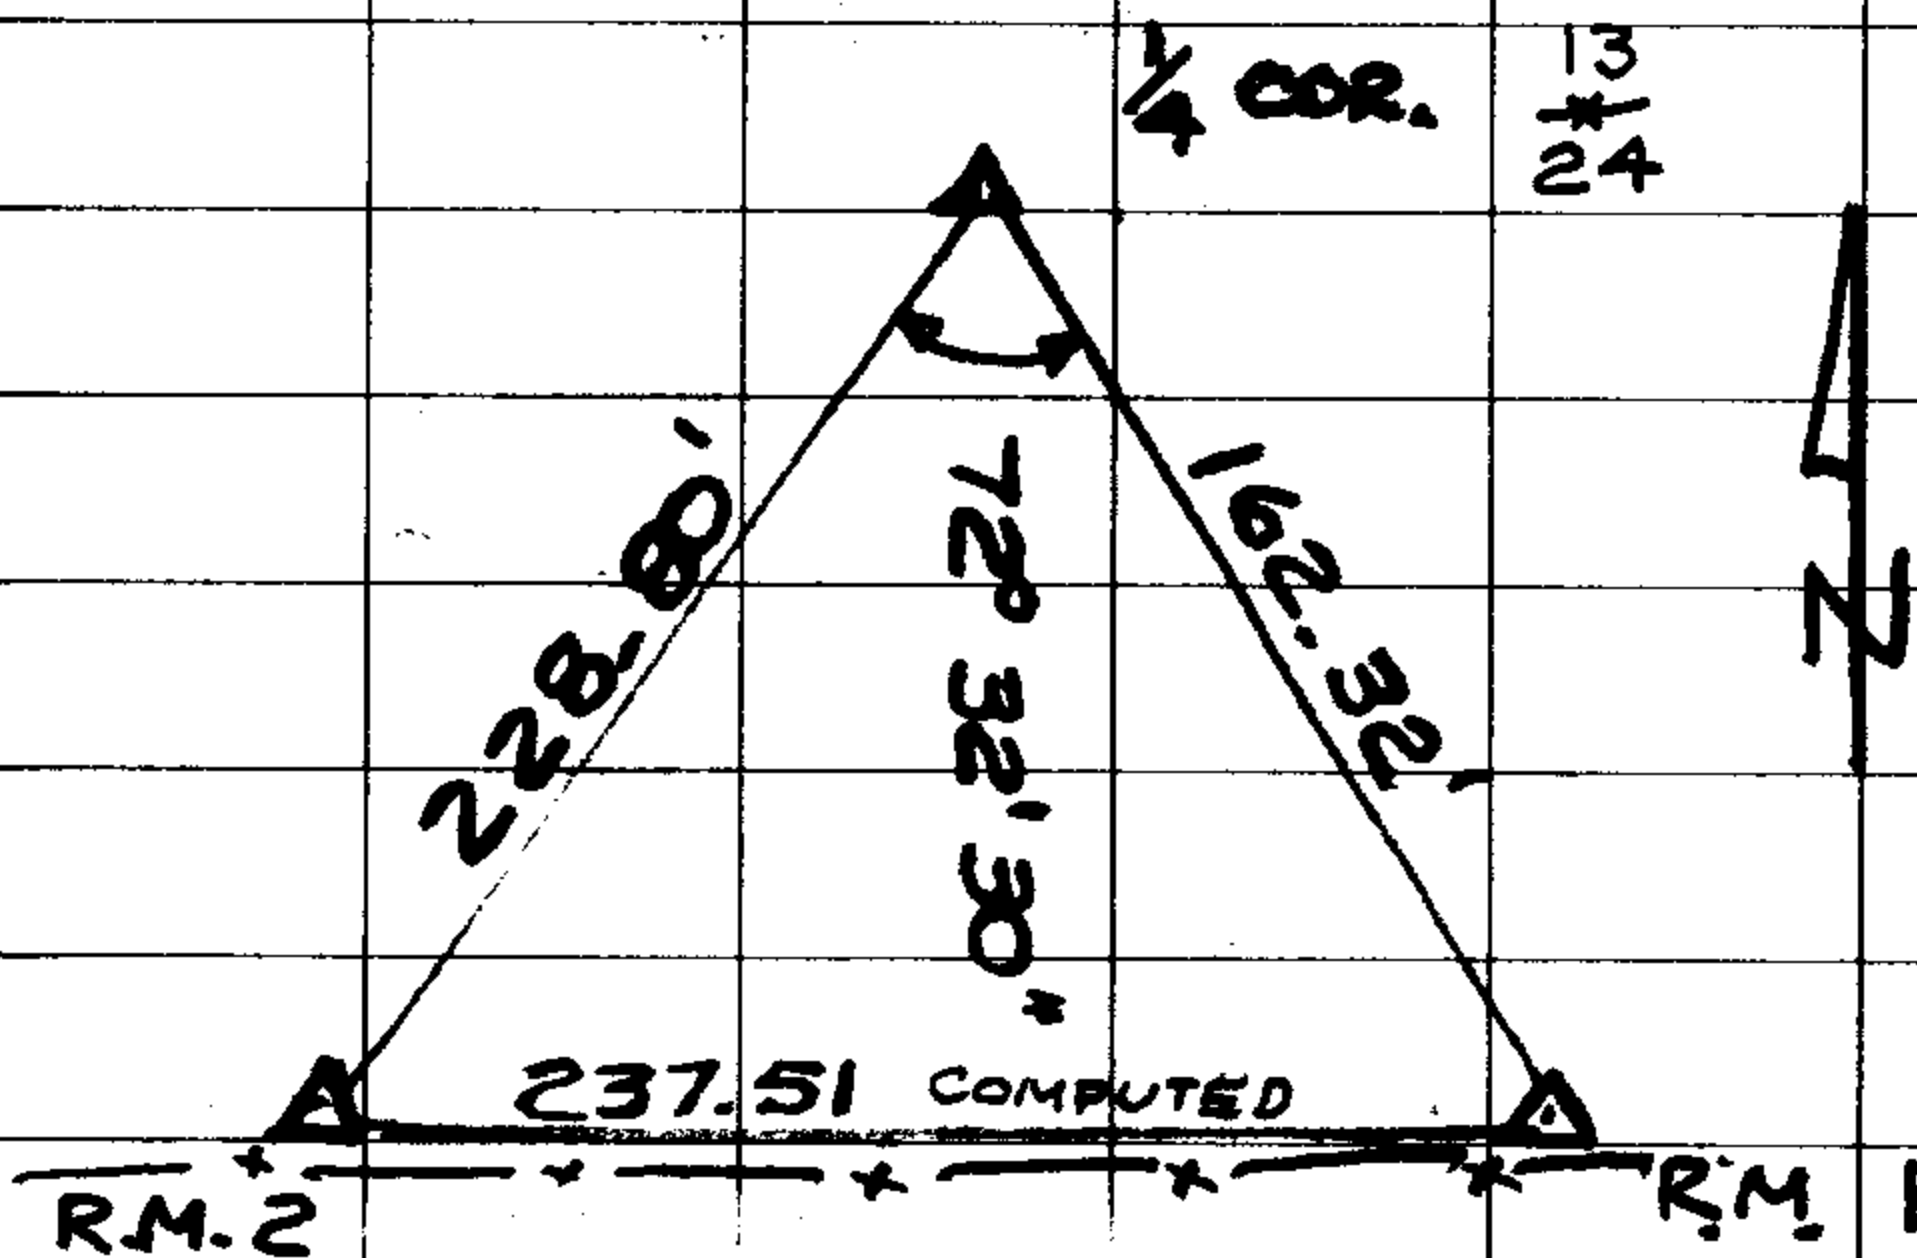

COMPASS DEC. IS 20° EAST

10-16-75

Gregory E. Zittel

DANNA L. INGRAM

ok

DEBBIE L. STEWART

C. S. File No. 57/36-17

X1 72° 31' 40"

X2 45° 05' 00"

MEAN 72° 32' 30"

1/4 COR-

TO

RM1

118.48
110.32
228.80'

132.55
104.90
237.45

BETWEEN
RM1 & RM2