

RENEWAL

T 21 S R 7 W

8738
518 | 517

(RENEWAL #29)

FOUND

1. 10 INCH NOW 11 INCH DIAMETER FIR
SCRIBED "S 8 T 21 S R 7 W" PARTIALLY
HEALED OVER, TAGGED, PARTIALLY
UPROOTED, AND, LEANING HEAVILY.
2. 8 INCH NOW 9 INCH DIAMETER FIR
HAS GOOD BLAZE - DID NOT OPEN.
TAGGED.
3. 8 INCH DIAMETER CHINQUAPIN SCRIBED
"S 17 T 21 S R 7 W C S BT" TAGGED.
4. 33 INCH NOW 33 1/2 INCH DIAMETER FIR
HAS GOOD BLAZE - DID NOT OPEN. TAGGED
5. 18 INCH NOW 18 1/2 INCH DIAMETER FIR
HAS GOOD BLAZE - DID NOT OPEN - TAGGED

#105 ✓

(1) C S. File No. 57/36-23

T21S R7W
S7/S8
S18/S17


RENEWAL

6. ORIGINAL, 8 INCH NOW 30 INCH DIAMETER FIR IS DOWN, HAS BEEN OPENED AND IS ROTTED. - TAGGED.

RENEWAL

SET BRASS CAP AT SECTION CORNER MARKED: COUNTY SURVEYOR'S OFFICE

T21S R7W

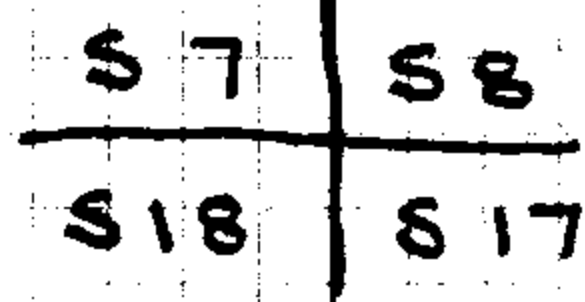

1975

BEARING TREES

11" DIAMETER FIR (SEE FOUND #1) SCRIBED "S8 T21S R7W CS BT" BEARS N 6° E 17² FEET (RECORD N 7 1/2° E 17³ FEET.)

9" DIAMETER FIR (SEE FOUND #2) SCRIBED "S7 CS BT" BEARS N 40° W 34² FEET (RECORD N 40° W 34[±] FEET)

DIETZEN NO. 3855-6

(2) C.S. HAS LIND. 57/36 / 23

T21S R7W
S17/S8
S18/S17

RENEWAL

8 INCH DIAMETER CHINQUAPIN (SEE
FOUND # 3) SCRIBED "S17 T21S R7W
CS BT" BEARS S80°E 23° FEET
(RECORD PER RENEWAL S78°E 23°
FEET; RECORD PER GOV'T. SURVEY
N88°E 27¹/₂ FEET)

33⁵/₈ INCH DIAMETER FIR (SEE FOUND
#4) SCRIBED "T21S R7W S17 BT"
BEARS S59¹/₂°E 80²/₂ FEET.
(RECORD PER GOV'T. SURVEY S64°E 79⁷/₂ FEET)

18⁵/₈ INCH DIAMETER FIR (SEE FOUND
#5) SCRIBED "T21S R7W S7 BT"
BEARS N52°W 42⁶/₂ FEET. (RECORD
PER GOV'T SURVEY N46°W 42²/₂ FEET)

30 INCH DIAMETER FIR (SEE FOUND #6)
BEARS N28°W 11⁵/₂ FEET (ORIGINAL
N19°W 16⁵/₂ FEET.)

NO NEW BEARING TREES SCRIBED
AS SECTION 18 HAS NO SUBSTANTIAL
TREES IN AREA OF CORNER

(3)

J. J. HIGGINS

57/36-23

CORNER LIES APPROX. 60' EASTERLY OF

BLM ROAD # 21-7-22; LINE CROSSING

TAG ON WESTERLY SIDE OF ROAD.

CORNER LIES NEAR THE TOP OF

SLIDE AREA. THE CORNER AND ALL

ACCESSORIES LIE ON A WESTERLY

SLOPE WITH SIGNS OF SEVERE

SHIFTING.

10-28-75

L.E. MONREAN

P.L. EARLE

J.N. COOK

OK
[Handwritten signature]

DIETZEN NO. 985-6

S. File No.

57/36-23