

RENEWAL

T275 R3 W

$\frac{1}{4}$   $\frac{S7}{S18}$

FOUND

U.S. BUREAU OF LAND MANAGEMENT CADASTRAL  
1. SURVEY BRASS CAP, STAMPED;

" T275 R3 W

$\frac{1}{4}$   $\frac{S7}{S18}$

1958

NOTE: CAP ON LOWER SIDE OF LOGGING  
SKID ROAD UNDER 1 $\frac{1}{2}$  FEET OF FILL. FOUND  
WOODEN STAKE SQUARED AT TOP, BROKEN  
OFF AT SURFACE, BOTTOM PORTION OF  
STAKE LOCATED BESIDE BASE OF  
BRASS CAP MONUMENT.

2. A CEDAR, 15 INCHES NOW 18 INCHES IN  
DIAMETER, BEARS N 32 $\frac{1}{2}$ ° W 96 $\frac{1}{2}$  FEET  
(REC. N 35 $\frac{1}{2}$ ° W 85 $\frac{1}{2}$  FEET) SCRIBED  
"  $\frac{1}{4}$  S7 BT ". UPPER PORTION OF  
BEARING TREE IS DEAD, HAS 35 INCH  
DIAMETER FIR LOG LODGED AGAINST  
WESTERLY SIDE.

#124 ✓

G. S. File No. 57/39

DISTRICT NO. 1885-6

127543W  
1/4 S7  
S18

RENEWAL

- 3. A 34 INCH DIAMETER FIR (A WINDFALL)  
THE APPROXIMATE CENTER OF STANDING  
LOCATION BEARS S 10 1/2° W 57 ±  
FEET (REC. S 6° W). TREE LIES FACING  
DOWNHILL TOWARD CORNER.

RENEWAL

- 1. AS MONUMENT IS 15 FEET BELOW  
SURFACE, I REFERENCE POSITION OF  
MONUMENT AND REPLACE MONUMENT AT  
REFERENCED POSITION WITH BRASS  
CAP ABOVE SURFACE, AT CORNER  
POINT.

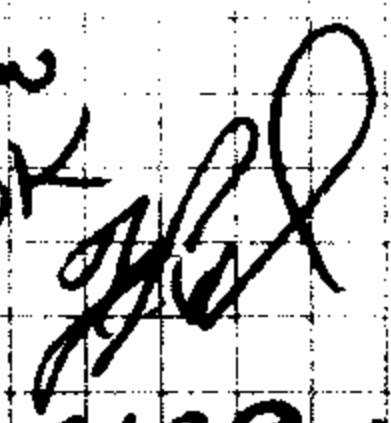
NEW BEARING TREES

A CEDAR, 18 INCH DIAMETER, BEARS  
S 85° W, 114 ± FEET, SCRIBED,  
" 1/4 S 18 CS BT "

11-14-75

L. E. MONREAN

A. L. E.

OK  


C. S. FILE NO. 57/39-11