

T 236 R 7 W
D L C 44
S W C O R .

RENEWAL

CORNER SET FROM
INFORMATION AS
DESCRIBED IN
1961 SURVEY
BY DON E. GARRETT MAR-11, C.S. FILE
55/2.

FOUND

1. BOLT SET FIRMLY IN GROUND, SHOWN
TO ME BY MR. FISHER, OWNER OF
THE PROPERTY. MR. FISHER INDICATED
THAT HE HAD HELPED GARRETT LOCATE
THE BOLT, AND THAT GARRETT HAD
USED IT AS THE SW CORNER
OF THE D.L.C.
 2. REMAINS OF CHARED WOODEN POST
1 FOOT DIRECTLY BELOW BOLT.
 3. 33 INCH DIAMETER W. OAK, BEARS
NORTH 55 1/2 FEET. TREE HAS TWO
BLAZES ON WEST SIDE.
- NOTE NO ORIGINAL BEARING TREES FOUND.

C.S. FILE NO. 57/32-21

#145 ✓

D

RENEWAL

RENEWAL


1. SET BRASS CAP AT SW CORNER

D.L.C. NO. 44, STAMPED;

" " " "

COUNTY SURVEYORS OFFICE

T 23 S R 7 W

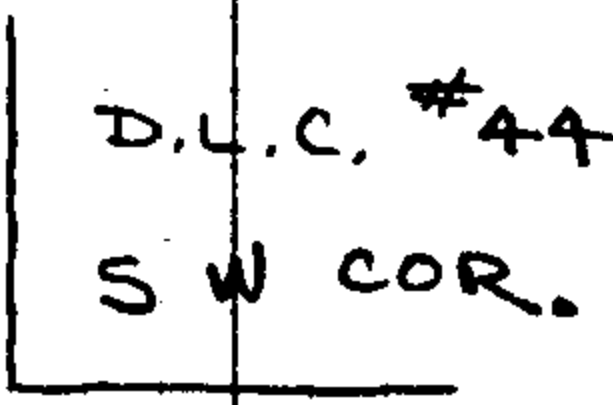

1975

BOLT SET ON NORTH SIDE OF CAP.

CAP SET APPROX. 1 FOOT ABOVE
GROUND LEVEL, IN MOUND OF STONE
APPROX 1 FOOT HIGH AND 2 1/2 FEET
DIAMETER AT BASE.

2. A WHITE OAK, 39 INCHES DIAMETER,
BEARS N 67° E, 146⁺ FEET DISTANCE.

TREE IS BLAZED AND SCRIBED
" T 23 S R 7 W SW COR DLC 44 CS BT."

12-2-75

L.E. MOUREAU

D.L.C.

J.H.C.

C.S. File No. 57/39-21

2)