

12-3-75

$\frac{1}{4}$ $\frac{15}{22}$ T21-7W

(SEE REN. # 36)

FR:

I. PIPE WITH BRASS CAP ATTACHED, FIRMLY SET, AND MARKED AS DESCRIBED BY THE COUNTY SURVEYOR IN 1959.

WE FIND THE ORIGINAL NE BEARING TREE AS DESCRIBED IN REN. # 36. IT BEARS N 63° E 4⁶ FT.

THE ORIGINAL SW BEARING TREE HAS BEEN DESTROYED.

WE FIND THE COUNTY SURVEYOR'S BT'S AS FOLLOWS:

A 10" NOW 14" HEMLOCK BEARS N 21° E 37⁴ FT., ALIVE AND WELL HEALED.

A 15" R. CEDAR, NOW A STUMP BEARS S 81° W 47³ FT., PARTIALLY BURIED IN LOGGING DEBRIS.

106'

CS. T. N.

~~57/39-24~~

NEW BT 12th MAPLE

S 22° W

17³ LVL

$\frac{1}{4}$ S 22 CS BT

WE MARK A NEW BEARING TREE:

A 12" MAPLE STUMP, WITH NUMEROUS SPROUTS
 GROWING FROM ITS TOP, BEARS S 22° W
 17 ³/₄ FT., SCRIBED "1/4 S 22 CS BT" ON A
 DOUBLE BLAZE.

NOTE:

THIS CORNER LIES ALONG AN E-W
 CUTTING LINE AT THE NORTH EDGE OF AN
 EXISTING CLEARCUT, APPROX. 250 FT. NORTH
 AND 75 FT. LOWER THAN A PAVED BLM ACCESS
 ROAD.

COMPASS DECLINATION SETTING: 20° EAST

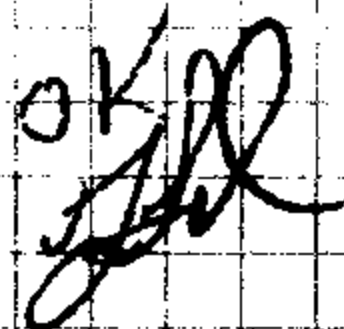
12-3-75

Gary L. Langlotz

CELLE. GOODWIN

A. VIC LANGIE

M. LENORA LADIG

OK


57/39-24
