

12-11-75

T295 R1E

HES # 179

CORNER # 2

FO:

A STONE, 25" X 7" X 5", FICHLT SET AND MARKED
AS DESCRIBED IN THE OFFICIAL RECORD,

FROM WHICH:

AN OBT, AN 8" NOW 14" RED CEDAR BEARS
N 30° W 15⁸ FT., (REC. N 9° W 15⁸ FT.)

ALIVE AND NEARLY HEALED, NO MARKS VISIBLE.

AND A BOULDER, 2¹/₂ FT. X 3 FT. X 3 FT. ABOVE
GROUND (MEASURED ON DOWNHILL SIDE)

MARKED WITH A CHISELED "BR" ON TOP,

ALL OTHER MARKINGS GONE, BEARS

S 45° E 32³/₄ FT.

AT THE CORNER POINT, WE SET A 1" X 30" I. PIPE
WITH BRASS CAP ATTACHED, MARKED:


C. S. File No. ~~57/39-30~~

119 - C

PAGE 1

DOUGLAS CO. SURVEYOR

T29S R1E

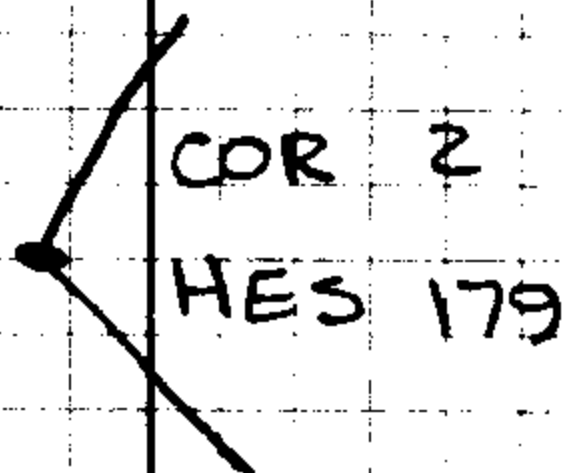

1975

WE PLACE THE ORIGINAL STONE ALONGSIDE
THE BRASS CAP.

NOTE:

THIS CORNER IS LOCATED APPROX.
300 FT. NW OF THE SOUTH UMPQUA ROAD.

COMPASS DECLINATION SETTING: 20° EAST

12-11-75

Gary J. Langley

CLELL E. GODWIN

M. LENORA LADIS

C. S. File No. 57/39-30