

SURVEY FOR DESCRIPTION FOR MORTGAGE PURPOSES

IN SECTIONS 10 & 15, T. 26S. R. 4W. W.M.

FOR: BOB CAMERON
BY: BURTON W. HOLT


AUGUST 1974

COUNTY SURVEYORS FILE DATA
DO NOT REMOVE FROM OFFICE

FILED ✓
RECEIVED ✓

SEP 3 1974

COUNTY SURVEYOR
DOUGLAS COUNTY, ORE.
mz

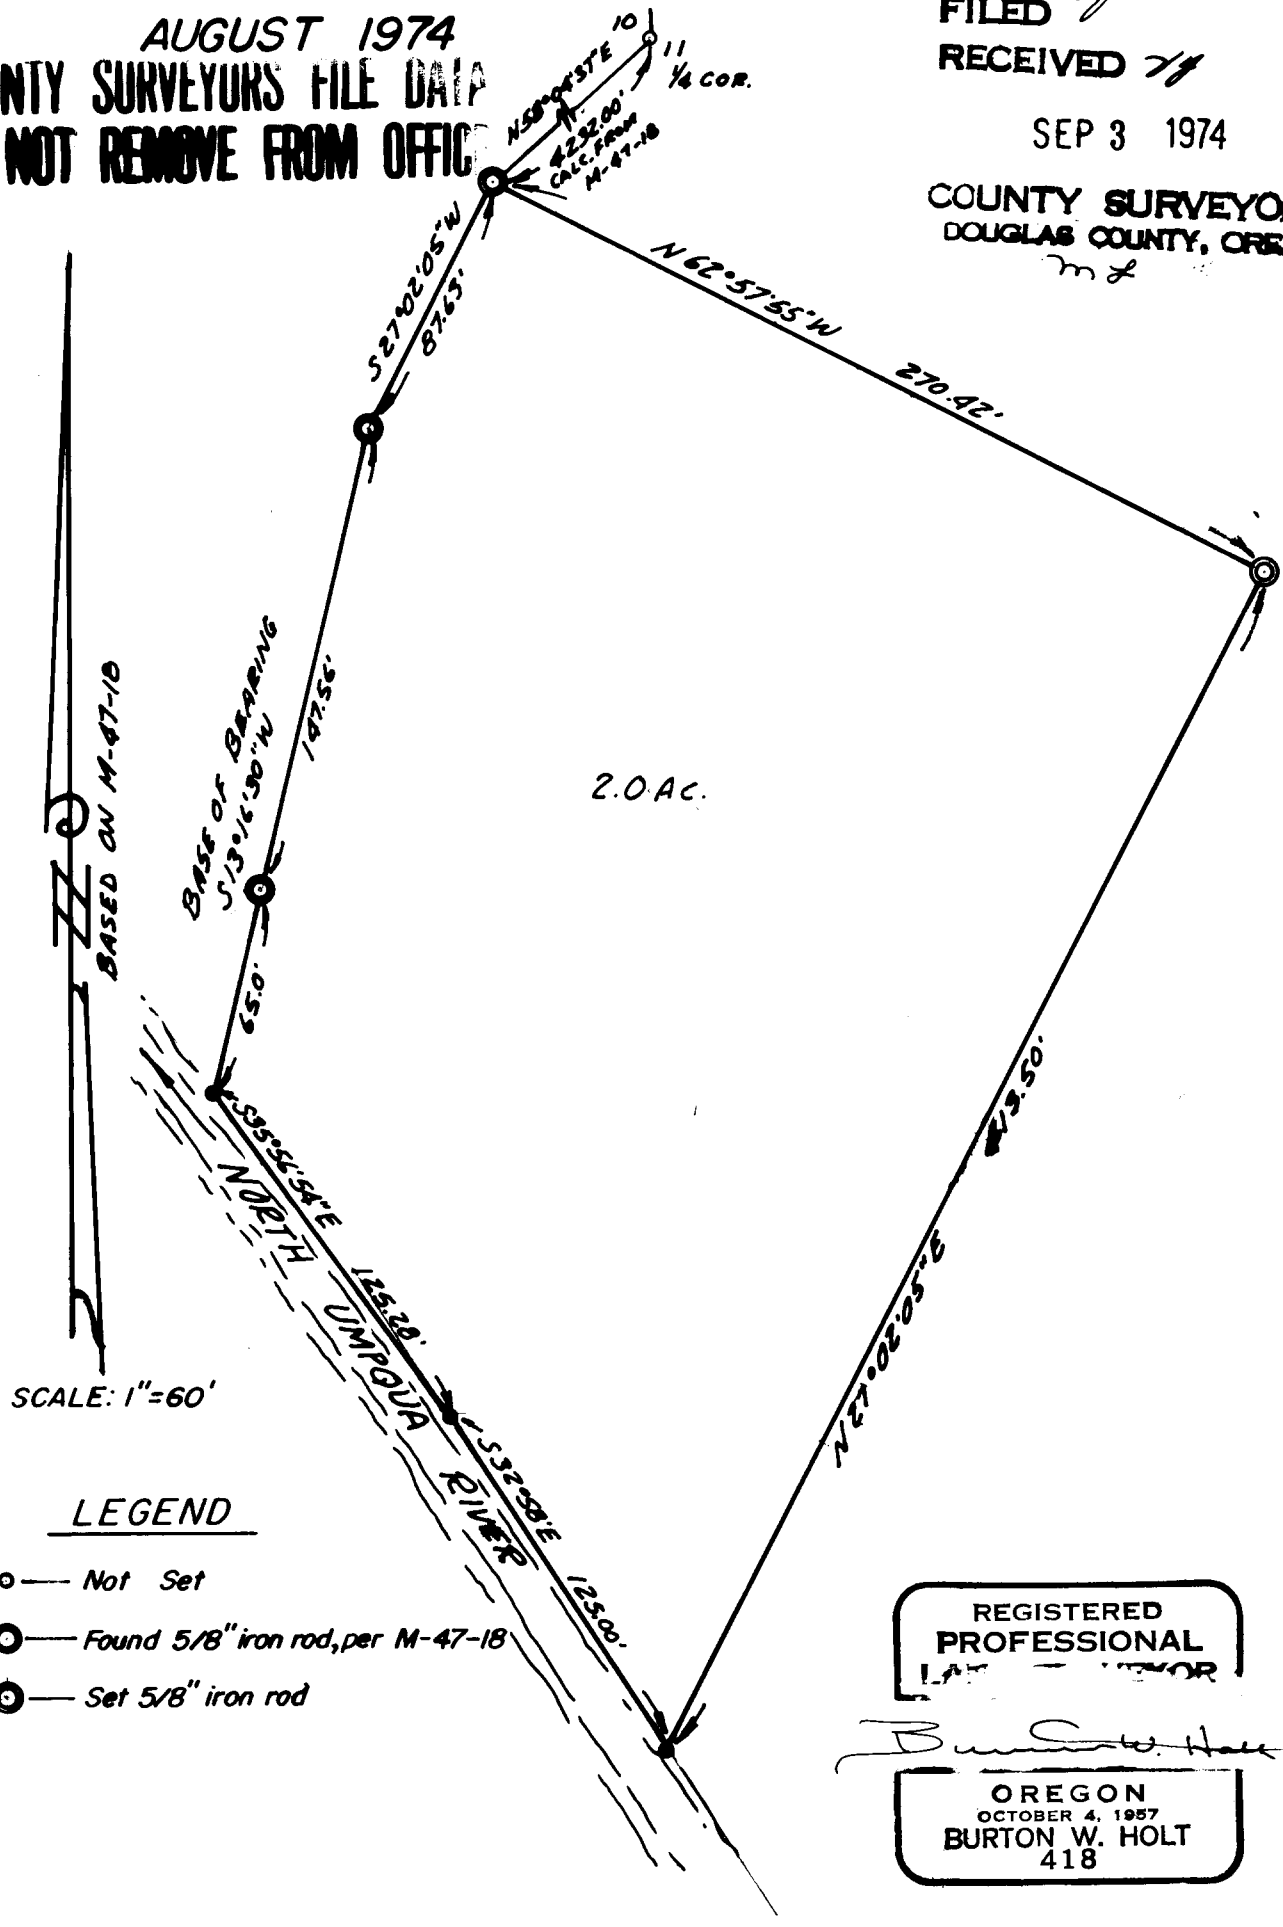

REGISTERED
PROFESSIONAL
LAND SURVEYOR

Burton W. Holt

OREGON
OCTOBER 4, 1957
BURTON W. HOLT
418