

SURVEY TO SET ONE - SIXTEENTH CORNER IN
SECTIONS 1 & 12 T.29S. R.3W. W.M.

FOR C & D LUMBER COMPANY
BY BURTON W. HOLT
SCALE 1" = 400'

FILED ✓
RECEIVED ✓


JAN 19 1978

JANUARY 1978


COUNTY SURVEYOR
DOUGLAS COUNTY, ORE.

✓

**COUNTY SURVEYORS FILE DATA
DO NOT REMOVE FROM OFFICE**

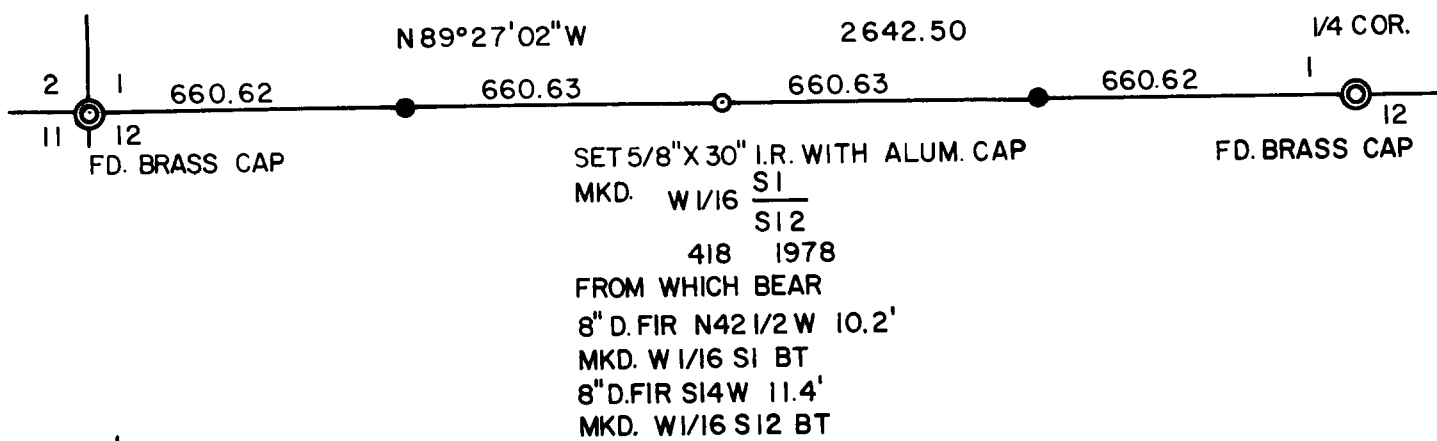

BASED ON NORTH & SOUTH CENTER LINE SECTION 12

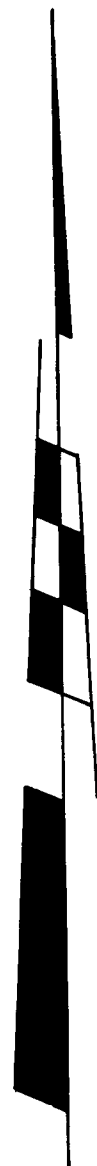

REGISTERED
PROFESSIONAL
LAND SURVEYOR

Burton W. Holt

OREGON
OCTOBER 4, 1987
BURTON W. HOLT
418

- SET AS SHOWN
- SET 6' STEEL FENCE POST
- ◎ FD. AS SHOWN