


E-2/85

FILED ✓  
RECEIVED *lt*

MAY 11 1976

COUNTY SURVEYOR  
DOUGLAS COUNTY, ORE.

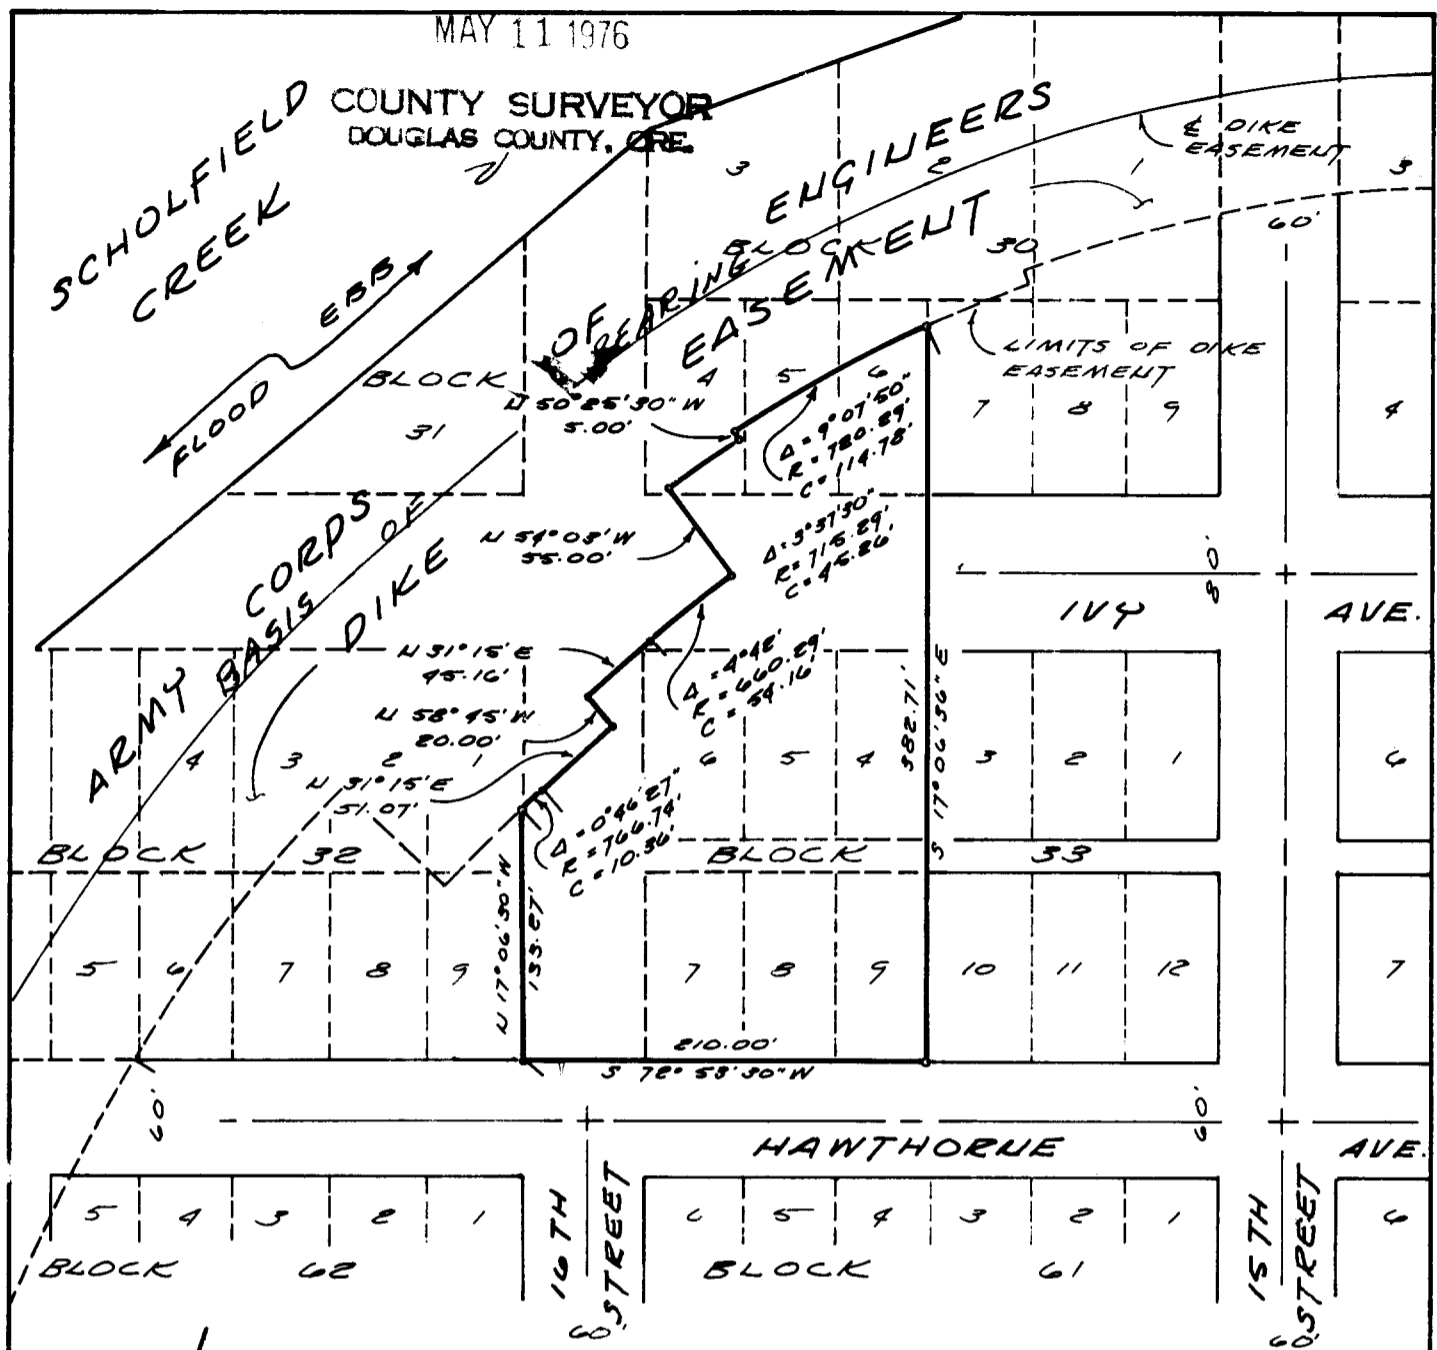

SCALE  
1" = 100'

DATE  
MAY 6, 1974

LEGEND  
• SET 3/4" IRON PIPE

REGISTERED  
PROFESSIONAL  
LAND SURVEYOR

*Robert W. Wade*

OREGON  
OCTOBER 4, 1957  
ROBERT W. WADE  
433

PROPERTY SURVEY

LOTS 9-9, BLOCK 33; A PORTION OF LOTS 4, 5, AND 6, BLOCK 30; TOGETHER WITH A PORTION OF VACATED 16TH STREET AND VACATED 14th AVENUE; ALL LOCATED IN THE AMENDED PLAT OF RAILROAD ADDITION TO THE CITY OF REEDSPORT, DOUGLAS COUNTY, OREGON  
T. 21 S R. 12 W SEC. 34

FOR: HEINZ KAUFMANN  
3100 GREENBRIAR  
REEDSPORT, OREGON

COUNTY SURVEYORS FILE OFFICE  
NOT REMOVE FROM OFFICE

ENGINEERS & PLANNERS  
COOS BAY, OREGON / 5th AND HIGHLAND 97420