


PUBLIC LAND CORNERS

WEYERHAEUSER COMPANY
 SPRINGFIELD BRANCH

TOWNSHIP 23S RANGE 2W
 SECTION 26 CORNER E $\frac{1}{2}$
 COUNTY Lane-Douglas OREGON

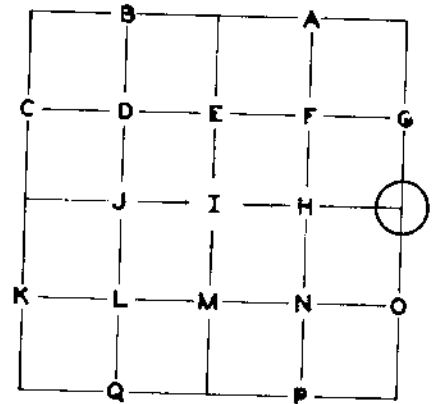

GLO SURVEY RECORD

CORNER stone DATE: 1894

PRESENT CONDITION - (DESCRIBE FULLY -
 USE PAGE 2 IF NEEDED FOR EXPLANATION.)

Stone 12 x 8 x 6, badly chipped but
 probable marks.

ACCESSORIES:

| | BEARING- | LINKS- | FEET- |
|---------|----------|--------|-------|
| 40" Fir | N63E | 8 | 5.3 |
| 40" Fir | S75W | 20 | 13.2 |

48" x 6' Fir stub of broken blowdown,
 healed over faces still intact.
 40" x 20' Fir snag, scribing visible.

Douglas County BT tags on the above trees.

Douglas County SURVEY RECORD

Corner stone not found. DATE Found: July, 1969
 Original 40" Fir, now 48" Fir N63E 5.3'
 with good scar.
 Original 40" Fir, now 40" Fir snag S75W 13.2'
 scribing visible on unhealed blazes.
 Set Brass Cap and scribed 2 new BTs"
 12" Hemlock N42E 19.6'
 12" Hemlock S40W 49.6'

PRESENT CONDITION:

As above.

As above.

Found Brass Cap.

14" Hemlock, scribed. Douglas Co. BT tag.
 12" Hemlock, scribed. Douglas Co. BT tag.

CORNER SET: ~~XXXXX~~

Douglas County Brass Cap


MAG. DECL.:

20°

BEARING AND DISTANCE TO ABOVE IDENTIFIED SURVEY ACCESSORIES:

| BEARING- | FEET- | SURVEY- | |
|----------|-------|---------|---------------------|
| N63E | 5.3 | 1894 | Center measurement. |
| S77W | 12.6 | 1894 | Center measurement. |
| N42E | 19.6 | 1969 | Center measurement. |
| S39W | 49.3 | 1969 | Center measurement. |

SECTION 26 TOWNSHIP 23S RANGE 2W

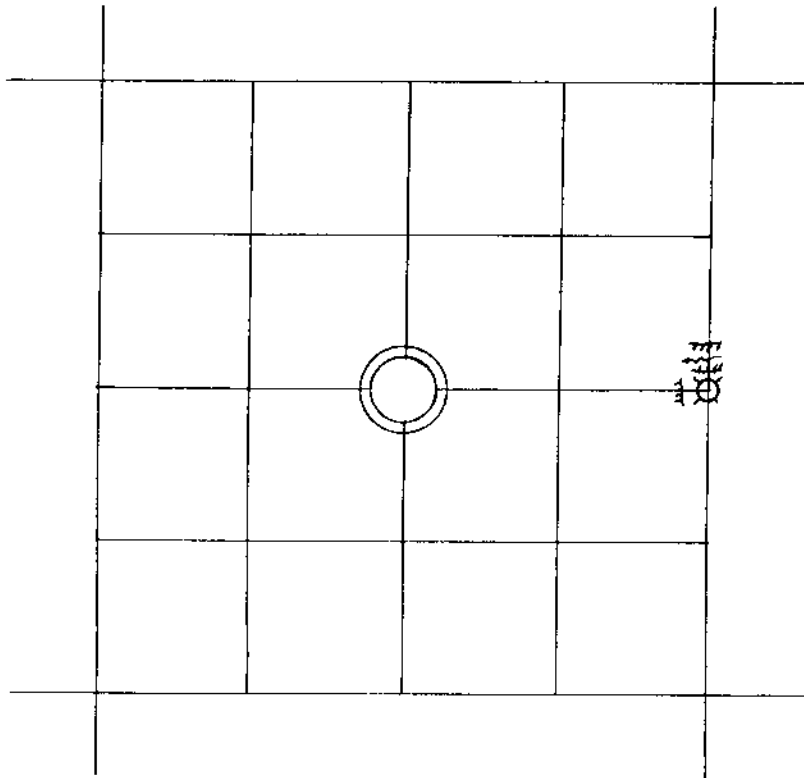

---//---//---//--- LINE MARKED BY NOTCH CUT IN BLAZE.

○---KNOWN CORNER.

⊗---REFERENCED CORNER
BY WEYERHAEUSER
METHOD.

A Georgia-Pacific survey plat of subdivision of Sec. 25, T23S, R2W, September 1962

(Lane County 18 x 27 file, print no. 12714) shows the following for this corner:

Present condition 6/4/1976

Found stone

*40" Fir N63E 13.2' BT BK tag.

BK tag not found.

*40" Fir snag S75W 5.3' BT BK tag

BK tag not found.

Set 1½ Iron pipe.

Pipe not found.

*Note discrepancy in distances, these
distances being reversed from GLO and
Douglas County calls.

ACCESSORIES ADDED THIS DATE:

MAGNETIC DECLINATION 20°

| | BEARING | FEET | ORIG. B.T. | 'W' NAIL | PLATE | BRASS DISC |
|---------------|---------|------|------------|----------|-------|------------|
| 42" Fir | S68E | 6.3 | --- | X | X | --- |
| 58" Fir Stump | S23W | 23.1 | --- | X | X | --- |
| | | | | | | |
| | | | | | | |

IDENTIFIED ON PHOTO:

INFORMATION ON LOCATION OF CORNER AS NOW SET:

Rhododendron, logging debris.

GROUND COVER:

(USING FORM LINES SKETCH TOPOG AT CORNER ON PAGE 2 PLAT)

SLOPE FACES (GIVE BEARING IN DEGREES) N45W ON MINUS (-) 72 %

NORTH: -35% for 55' then descend over rock bluff into draw course West.

FROM CORNER | SOUTH: +35%

EAST: +60%

WEST: -70% for 55' then descend over rock bluff.

WORK DONE FOR W. CO.

FIELD NOTES IN BOOK:

BY: Glen McChesney DATE: June 4, 1976
Project XXXXXXXXX
ENGINEER - SURVEYOR

UNDER THE SUPERVISION OF:

REGISTERED PROFESSIONAL LAND SURVEYOR

Frank O. Williams

OREGON
JULY 12, 1968
FRANK O. WILLIAMS
0875

ASSISTED BY:

COPIES SENT TO:

SEAL

58/8

| | | | | | | | |
|----|----|----|----|----|----|----|----|
| 36 | 31 | 32 | 33 | 34 | 35 | 36 | 31 |
| 1 | 6 | 5 | 4 | 3 | 2 | 1 | 6 |
| 12 | 7 | 8 | 9 | 10 | 11 | 12 | 7 |
| 13 | 18 | 17 | 16 | 15 | 14 | 13 | 18 |
| 24 | 19 | 20 | 21 | 22 | 23 | 24 | 19 |
| 25 | 30 | 29 | 28 | 27 | 26 | 25 | 30 |
| 36 | 31 | 32 | 33 | 34 | 35 | 36 | 31 |
| 1 | 6 | 5 | 4 | 3 | 2 | 1 | 6 |

WEYERHAEUSER COMPANY

CORNER REFERENCE METHOD CONSISTS OF:

A "W" NAIL DRIVEN THRU THE HOLE IN A BRASS DISC, INTO A NOTCH CUT LOW ON A TREE, STAMPED WITH THE OREGON REGISTERED LAND SURVEYOR OR PROFESSIONAL ENGINEER REGISTRATION NUMBER.

AN EMBOSSED ALUMINUM PLATE, NAILED HEAD HIGH ON SAME TREE WITH 8D ALUMINUM NAILS, WITH DISTANCE AND BEARING FROM THE "W" NAIL TO THE CORNER STAMPED ON IT.

