



PUBLIC LAND CORNERS

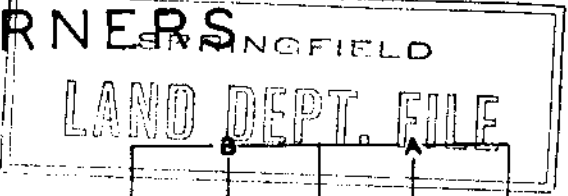

RECEIVED *JR*

WEYERHAEUSER COMPANY JUN 3 1981
 COUNTY SURVEYOR
 SPRINGFIELD BRANCH DOUGLAS COUNTY, ORE.

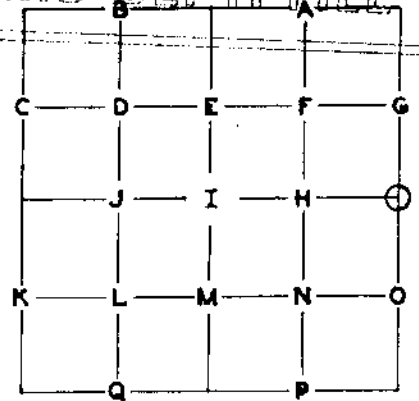

TOWNSHIP 23S RANGE 2W
 SECTION 31 CORNER E $\frac{1}{2}$
 COUNTY DOUGLAS OREGON

GLO SURVEY RECORD			
CORNER Post		DATE: 1894	
ACCESSORIES:			
	BEARING-	LINKS-	FEET-
50" Fir	S85°W	31	20.5
16" Fir	N2°E	16	10.6

PRESENT CONDITION - (DESCRIBE FULLY USE PAGE 2 IF NEEDED FOR EXPLANATION.)	
No Trace	


Weyerhaeuser SURVEY RECORD	
DATE: 9/18/1957	
M.D. Hale - Found 2 original BT's, 50" fir N81°W (record S85°W) 20.5' base of rotted 16" fir N2°E 10.6' with scribed fragments left at stump. Referenced (W.CO. plates & "W"nails)	
54" Fir	N81°W 20.1 Orig. BT
46" Fir	S25°E 22.4

PRESENT CONDITION:	
54" Fir stump - lowface healed over, square "W" nail	
46" Fir stump with square "W" nail	

CORNER SET: 5/8" aluminum pipe at corner point as MAG. DECL.: 20°
 determined by M.D. Hale from his reference record.

BEARING AND DISTANCE TO ABOVE IDENTIFIED SURVEY ACCESSORIES:			
BEARING-	FEET-	SURVEY-	
<u>N79°W</u>	20.5	GLO	
N2°E	10.6	GLO	
S25°E	22.4	Hale	

#37 ✓

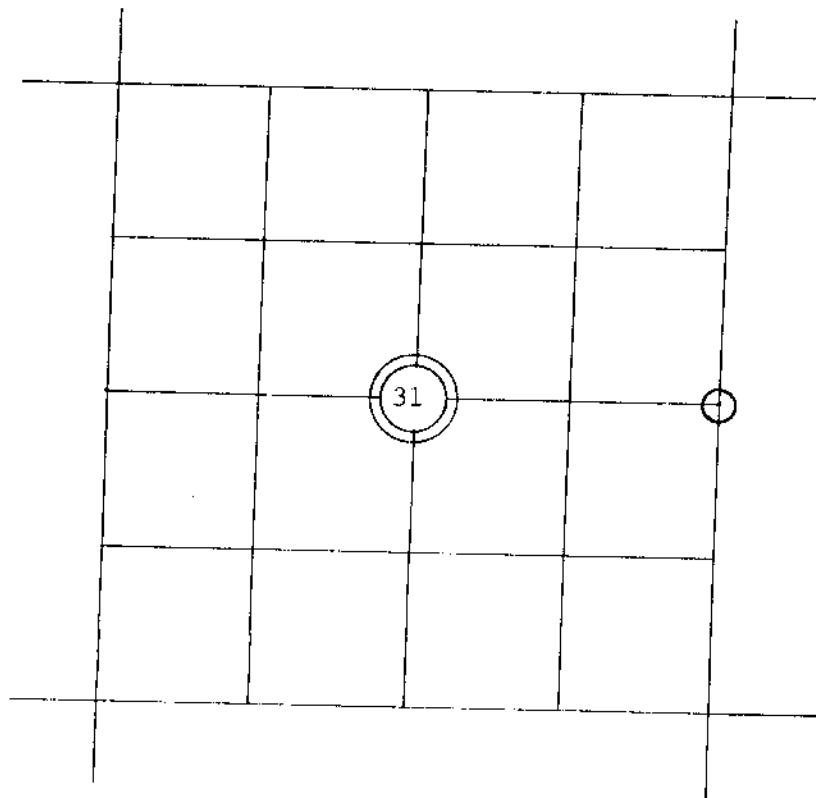

FILED
 RECEIVED *JR*
 JUN 3 1981
 COUNTY SURVEYOR
 DOUGLAS COUNTY, ORE.

— // // // — LINE MARKED BY NOTCH CUT IN BLAZE.

○ — KNOWN CORNER.

⊗ — REFERENCED CORNER
 BY WEYERHAEUSER
 METHOD.

M.D. Hale noted a discrepancy in the bearing to the 50" Fir BT as being N81°W instead of S85°W after determining the corner point by distances and noting the bearing to the NE BT as being good. After determining the corner point from Hale's called distances and bearings, I concur with his findings, except I have N79°W instead of N81°W to the original 50: Fir BT.

Under "Accessories Added This Date" (Page 3) I have driven round "W" nails beside Hale's square ones, put new plates on his reference trees (now stumps), changing the one to read N79°W instead of N81°W, and have added the one new reference.

ACCESSORIES ADDED THIS DATE:

MAGNETIC DECLINATION 20°

	BEARING	FEET	ORIG. B.T.	"W" NAIL	PLATE	BRASS DISC
54" Fir stump	N79°W	20.1	Original & Hale	X	X	
46" Fir stump	S25°E	22.4	Hale	X	X	
24" Fir stump (10/18/68)	N38°E	12.5	-	X	X	

IDENTIFIED ON PHOTO:

INFORMATION ON LOCATION OF CORNER AS NOW SET:

GROUND COVER: Logging debris

(USING FORM LINES SKETCH TOPOG AT CORNER ON PAGE 2 PLAT)

SLOPE FACES (GIVE BEARING IN DEGREES) S40°W ON MINUS (-) 62 %

NORTH: + 62%

SOUTH: - 62%

EAST: + 35%

WEST: - 25%

FROM CORNER |

FILED RECEIVED *JK*

JUN 3 1981

COUNTY SURVEYOR DOUGLAS COUNTY, ORE.

WORK DONE FOR W. CO.

FIELD NOTES IN BOOK:

BY: Glen McChesney DATE: 10/18/68
ENGINEER & SURVEYOR

ASSISTED BY:

COPIES SENT TO: Douglas County Surveyor

UNDER THE SUPERVISION OF:

SEAL

C. S. File No.

58/6

PAGE 3

36	31	32	33	34	35	36	31
1	6	5	4	3	2	1	6
12	7	8	9	10	11	12	7
13	18	17	16	15	14	13	18
24	19	20	21	22	23	24	19
25	30	29	28	27	26	25	30
36	31	32	33	34	35	36	31
1	6	5	4	3	2	1	6

WEYERHAEUSER COMPANY

CORNER REFERENCE METHOD CONSISTS OF:

A "W" NAIL DRIVEN THRU THE HOLE IN A BRASS DISC, INTO A NOTCH CUT LOW ON A TREE, STAMPED WITH THE OREGON REGISTERED LAND SURVEYOR OR PROFESSIONAL ENGINEER REGISTRATION NUMBER.

AN EMBOSSED ALUMINUM PLATE, NAILED HEAD HIGH ON SAME TREE WITH 8D ALUMINUM NAILS, WITH DISTANCE AND BEARING FROM THE "W" NAIL TO THE CORNER STAMPED ON IT.

