


PUBLIC LAND CORNERS

FILED
RECEIVED *J*

WEYERHAEUSER COMPANY JUN 3 1981
SPRINGFIELD BRANCH

COUNTY SURVEYOR
DOUGLAS COUNTY, ORE.

TOWNSHIP 23 S RANGE 4 W
SECTION 12 CORNER W 1/16 "B"
COUNTY Douglas OREGON

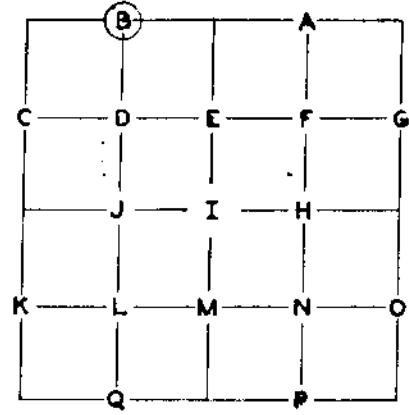


GLO SURVEY RECORD	PRESENT CONDITION - (DESCRIBE FULLY - USE PAGE 2 IF NEEDED FOR EXPLANATION.)
DATE: _____ CORNER <u>Not set by GLO</u>	
ACCESSORIES:	
BEARING- LINKS- FEET-	
W.N. Haines SURVEY RECORD DATE: <u>Nov. 1963</u>	PRESENT CONDITION: _____
Transit Survey Set 1"x36" "T" iron and scribed:	Found "T" iron in place
20" Incense Cedar N 6 W 18.0	20" Incense Cedar- scribing visible
40" Fir S 75 E 24.6'	40" Fir-upper face bark scribed, lower face in wood and pitched over.

CORNER SET: "T" iron as set by Haines, Survey MAG. DECL.: 20degrees

BEARING AND DISTANCE TO ABOVE IDENTIFIED SURVEY ACCESSORIES:

BEARING-	FEET-	SURVEY-	
N 6 W	18.0	Haines 63	To scribed face
S 75 E	25.0	"	To scribed face (26.5 to center of tree).

SECTION 12 TOWNSHIP 23 S RANGE 4 W

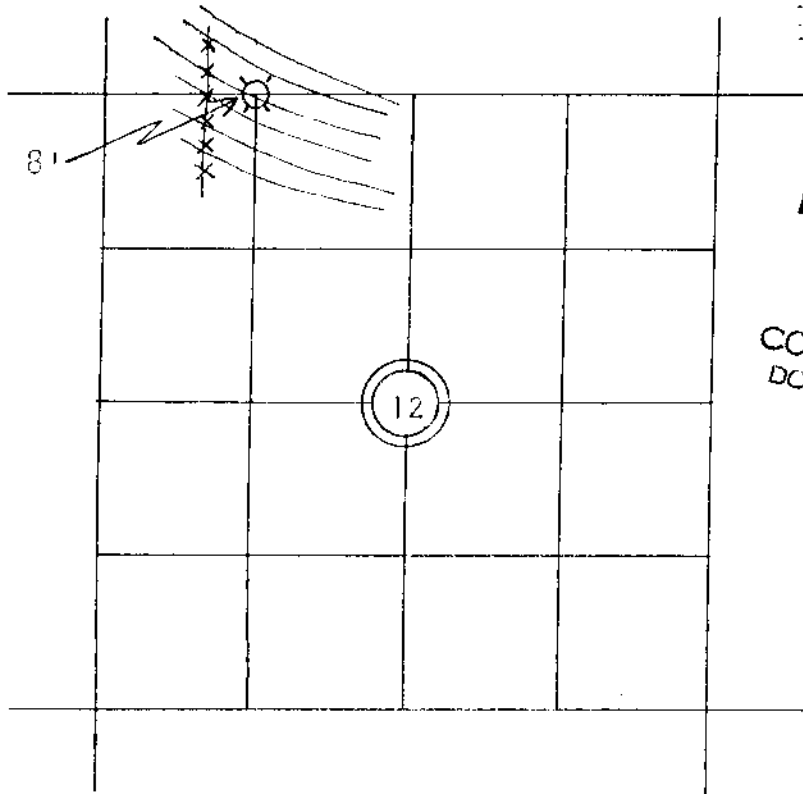

FILED
RECEIVED
JUN 3 1981
COUNTY SURVEYOR
DOUGLAS COUNTY, ORE.

— // — // — // — LINE MARKED BY NOTCH CUT IN BLAZE.

○ KNOWN CORNER.

⊗ REFERENCED CORNER
BY WEYERHAEUSER
METHOD.

ACCESSORIES ADDED THIS DATE:

MAGNETIC DECLINATION 20 degrees

	BEARING	FEET	ORIG. B.T.	"W" NAIL	PLATE	BRASS DISC
20" Incense Cedar	N 6 W	17.8	Haines	x	x	---
20" Douglas Fir	S 75 E	24.6	"	x	x	---

FILED RECEIVED

JUN 3 1981

IDENTIFIED ON PHOTO:

INFORMATION ON LOCATION OF CORNER AS NOW

COUNTY SURVEYOR
DOUGLAS COUNTY, ORE.

GROUND COVER: Grass, poison oak

(USING FORM LINES SKETCH TOPOG AT CORNER ON PAGE 2 PLAT)

SLOPE FACES (GIVE BEARING IN DEGREES) S 20 W ON MINUS (-) 66 %

FROM CORNER ↓

NORTH: + 64% Along west erly edge of tbr, open to west; along east side of N-S fence.

SOUTH: - 60% along east side of fence for 150'. Residual trees to east, open to west.

EAST: + 43% Timber to North, residual trees to south.

WEST: - 25% 8' to N-S fence. 100' to top edge of rock pit.

WORK DONE FOR W. CO.

FIELD NOTES IN BOOK:

by: Glen McChesney DATE: 8/6/68

~~ENGINEER~~ - SURVEYOR

ASSISTED BY:

UNDER THE SUPERVISION OF:

COPIES SENT TO:

SEAL PAGE 3

C. S. File No. 59/8

36	31	32	33	34	35	36	31
1	6	5	4	3	2	1	6
12	7	8	9	10	11	12	7
13	18	17	16	15	14	13	18
24	19	20	21	22	23	24	19
25	30	29	28	27	26	25	30
36	31	32	33	34	35	36	31
1	6	5	4	3	2	1	6

WEYERHAEUSER COMPANY

CORNER REFERENCE METHOD CONSISTS OF:

A "W" NAIL DRIVEN THRU THE HOLE IN A BRASS DISC, INTO A NOTCH CUT LOW ON A TREE, STAMPED WITH THE OREGON REGISTERED LAND SURVEYOR OR PROFESSIONAL ENGINEER REGISTRATION NUMBER.

AN EMBOSSED ALUMINUM PLATE, NAILED HEAD HIGH ON SAME TREE WITH 8D ALUMINUM NAILS, WITH DISTANCE AND BEARING FROM THE "W" NAIL TO THE CORNER STAMPED ON IT.

