


# PUBLIC LAND CORNERS

*# 4/21/77: SEE ALSO Ren. # 118*

WEYERHAEUSER COMPANY  
SPRINGFIELD BRANCH

TOWNSHIP 24S RANGE 1W  
SECTION 8 CORNER N $\frac{1}{2}$   
COUNTY Douglas OREGON

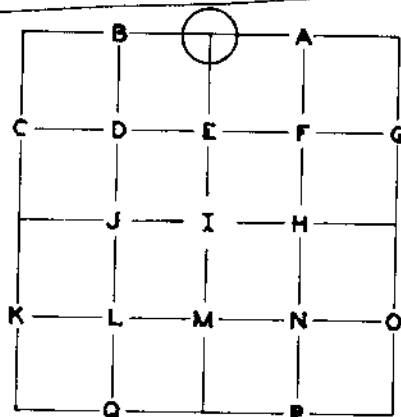

GLO SURVEY RECORD				PRESENT CONDITION - (DESCRIBE FULLY - USE PAGE 2 IF NEEDED FOR EXPLANATION.)	
DATE: <u>1896</u>					
CORNER <u>stone 20 x 8 x 8 marked <math>\frac{1}{2}</math> on North face.</u>				Stone marked $\frac{1}{2}$ alongside brass cap.	
ACCESSORIES:					
20" Fir	BEARING- N49E	LINKS- 47	FEET- 31.0	36" Fir, face healed over. BLM BT tag.	
20" Fir	S25W	19	12.5	26" Fir, face healed over. BLM BT tag.	
GLO Re- SURVEY RECORD				PRESENT CONDITION:	
DATE: <u>1963</u>					
Found original stone and 2 BTs:				As above.	
35" Fir N49E 47 lks.				As above.	
26" Fir S25W 19 lks.				As above.	

CORNER ~~XXXX~~ brass cap with original stone alongside. MAG. DECL.: 20°

BEARING AND DISTANCE TO ABOVE IDENTIFIED SURVEY ACCESSORIES:

BEARING -	FEET -	SURVEY -	
N51E	31.0	1896	Center of tree measurement.
S26W	13.1	1896	Center of tree measurement.



ACCESSORIES ADDED THIS DATE:

MAGNETIC DECLINATION 20°

	BEARING	FEET	ORIG. B.T.	"W" NAIL	PLATE	BRASS DISC
36" Fir	N50E	29.7	X	X	X	---
26" Fir	S26W	11.8	X	X	X	---
42" Fir	S81W	104.5	---	X	X	---
42" Fir	N19W	96.4	---	X	X	---

IDENTIFIED ON PHOTO:

INFORMATION ON LOCATION OF CORNER AS NOW SET:

GROUND COVER: Rhododendron, Salal, Chinquapin

(USING FORM LINES SKETCH TOPOG AT CORNER ON PAGE 2 PLAT)

SLOPE FACES (GIVE BEARING IN DEGREES) S20E ON MINUS (-) 50 %

FROM CORNER |

NORTH: +52%

SOUTH: -50%

EAST: -5%

WEST: +8%

WORK DONE FOR W. CO.

FIELD NOTES IN BOOK:

BY: Glen McChesney DATE: June 24, 1976  
Project ENGINEER - ~~SURVEYOR~~

ASSISTED BY:

COPIES SENT TO:

UNDER THE SUPERVISION OF:

REGISTERED PROFESSIONAL LAND SURVEYOR

*Frank O. Williams*

OREGON  
JULY 1, 1911  
FRANK O. WILLIAMS  
L.S. 1211

SEAL

PAGE 3

C. S. File No. 58/B

36	31	32	33	34	35	36	31
1	6	5	4	3	2	1	6
12	7	8	9	10	11	12	7
13	18	17	16	15	14	13	18
24	19	20	21	22	23	24	19
25	30	29	28	27	26	25	30
36	31	32	33	34	35	36	31
1	6	5	4	3	2	1	6

## WEYERHAEUSER COMPANY

CORNER REFERENCE METHOD CONSISTS OF:

A "W" NAIL DRIVEN THRU THE HOLE IN A BRASS DISC, INTO A NOTCH CUT LOW ON A TREE, STAMPED WITH THE OREGON REGISTERED LAND SURVEYOR OR PROFESSIONAL ENGINEER REGISTRATION NUMBER.

AN EMBOSSED ALUMINUM PLATE, NAILED HEAD HIGH ON SAME TREE WITH 8D ALUMINUM NAILS, WITH DISTANCE AND BEARING FROM THE "W" NAIL TO THE CORNER STAMPED ON IT.

