


PUBLIC LAND CORNERS

FILED RECEIVED *vh*

DEC 22 1980

WEYERHAEUSER COMPANY
SPRINGFIELD BRANCH
COUNTY SURVEYOR
DOUGLAS COUNTY, ORE.

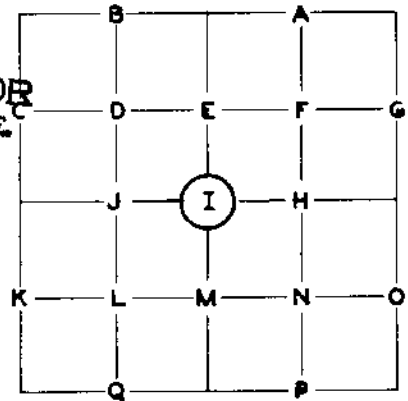

TOWNSHIP 24S RANGE 1W

SECTION 28 CORNER C_{1/2}

COUNTY Douglas OREGON

GLO SURVEY RECORD

DATE: _____

CORNER _____

PRESENT CONDITION - (DESCRIBE FULLY - USE PAGE 2 IF NEEDED FOR EXPLANATION.)

ACCESSORIES:

	BEARING-	LINKS-	FEET-

T. E. Shrum, Jr. SURVEY RECORD
DATE: Oct. 1972

Survey for Menasha Corp.
Set 2 1/2" aluminum cap.
18" Hemlock S37 1/2 E 17.8'
30" D. Fir S57 W 2.8'
8" Hemlock N11 1/2 W 38.7'

PRESENT CONDITION: _____

Found cap in place.
18" Hemlock stump, scribing visible.
26" Fir stump, scribing visible.
9" Hemlock " "

CS Map File M50-44

CORNER SET ~~XXXXX~~ 2 1/2" Aluminum cap as found

MAG. DECL.: 20° E

BEARING AND DISTANCE TO ABOVE IDENTIFIED SURVEY ACCESSORIES:

BEARING-	FEET-	SURVEY-	
S37E	17.8	1972	Face measurement; 18.4' to center
S60W	1.5	1972	Face measurement; 2.6' to center
N10W	38.3	1972	Face measurement; 38.7' to center

#137 X

ACCESSORIES ADDED THIS DATE:

MAGNETIC DECLINATION 20°

	BEARING	FEET	ORIG. B.T.	"W" NAIL	PLATE	BRASS DISC
38" D. Fir Stump	S30E	13.6	---	X	X	---
26" D. Fir Stump	S60W	1.4	1972	X	X	---

IDENTIFIED ON PHOTO:

INFORMATION ON LOCATION OF CORNER AS NOW SET:

Recent logging slash

GROUND COVER: _____

(USING FORM LINES SKETCH TOPOG AT CORNER ON PAGE 2 PLAT)

SLOPE FACES (GIVE BEARING IN DEGREES) N20E ON MINUS (-) 45 %

NORTH: - 40%

SOUTH: +30% 15' to cat fire trail; + 45% 60' to logging road.

EAST: -25% approx. 175' to draw course North.

WEST: +7% along cat fire trail.

WORK DONE FOR W. CO. _____

FIELD NOTES IN BOOK: _____

BY: Glen McChesney DATE: 10/21/77
Project XXXXXXXXXX
ENGINEER - SURVEYOR

UNDER THE SUPERVISION OF:

REGISTERED PROFESSIONAL LAND SURVEYOR

Frank O. Williams

OREGON
JULY 12, 1969
FRANK O. WILLIAMS
0872

ASSISTED BY: _____

COPIES SENT TO: _____

FILED RECEIVED
DEC 22 1980
COUNTY SURVEYOR
DOUGLAS COUNTY, ORE

SEAL PAGE 3

C. S. File No. 59/B

36	31	32	33	34	35	36	31
1	6	5	4	3	2	1	6
12	7	8	9	10	11	12	7
13	18	17	16	15	14	13	18
24	19	20	21	22	23	24	19
25	30	29	28	27	26	25	30
36	31	32	33	34	35	36	31
1	6	5	4	3	2	1	6

WEYERHAEUSER COMPANY

CORNER REFERENCE METHOD CONSISTS OF:

A "W" NAIL DRIVEN THRU THE HOLE IN A BRASS DISC, INTO A NOTCH CUT LOW ON A TREE, STAMPED WITH THE OREGON REGISTERED LAND SURVEYOR OR PROFESSIONAL ENGINEER REGISTRATION NUMBER.

AN EMBOSSED ALUMINUM PLATE, NAILED HEAD HIGH ON SAME TREE WITH 8D ALUMINUM NAILS, WITH DISTANCE AND BEARING FROM THE "W" NAIL TO THE CORNER STAMPED ON IT.

