

PUBLIC LAND CORNERS


FILED
RECEIVED *JK*

WEYERHAEUSER COMPANY DEC 22 1980
SPRINGFIELD BRANCH COUNTY SURVEYOR
DOUGLAS COUNTY, ORE.

TOWNSHIP 24S RANGE 2W

SECTION 28 CORNER W $\frac{1}{4}$

COUNTY Douglas OREGON

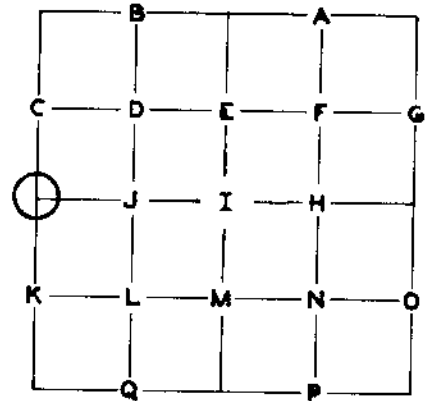

GLO SURVEY RECORD				PRESENT CONDITION - (DESCRIBE FULLY - USE PAGE 2 IF NEEDED FOR EXPLANATION.)
CORNER <u>Cedar Post</u> DATE: <u>1883</u>				<u>No trace</u>
ACCESSORIES:				
24" Hemlock	BEARING- N 40 E	LINKS- 16	FEET- 10.6	38" Hemlock, Scribing visible 32" Fir, Scribing Visible
18" Fir	N 50 W	32	21.1	
GLO SURVEY RECORD				PRESENT CONDITION:
Set brass cap from the original bearing trees by distance DATE: <u>1951</u>				<u>Found brass cap in place</u>
36" Hemlock N 40 E, 16 lks., 10.6'				<u>As above</u>
30" Fir N 53 $\frac{1}{2}$ W, 32 lks., 21.1'				<u>As above</u>
(Record N 50 W)				

CORNER XXX Set: Brass cap as found. Drove 2" fir post alongside brass cap. MAG. DECL.: 20⁰

BEARING AND DISTANCE TO ABOVE IDENTIFIED SURVEY ACCESSORIES:

BEARING-	FEET-	SURVEY-	
N 44 $\frac{1}{2}$ E	10.7	GLO	From brass cap to center of BT
N 53 $\frac{1}{2}$ W	21.1	GLO	From brass cap to center of BT

#105 ✓

ACCESSORIES ADDED THIS DATE:

MAGNETIC DECLINATION 200

	BEARING	FEET	ORIG. B.T.	'W' NAIL	PLATE	BRASS DISC
38" Hemlock	N 42 E	8.6	X	X	X	---
32" Fir	N 52½ W	20.4	X	X	X	----

IDENTIFIED ON PHOTO:

INFORMATION ON LOCATION OF CORNER AS NOW SET:

GROUND COVER: Old growth fir, Hemlock & Yew

(USING FORM LINES SKETCH TOPOG AT CORNER ON PAGE 2 PLAT)

SLOPE FACES (GIVE BEARING IN DEGREES) South ON MINUS (-) 5 %

NORTH: +5% for 150'

FROM CORNER | SOUTH: -5% for 125'

EAST: Level for 75'

WEST: -10% for 50'

WORK DONE FOR W. CO.

FIELD NOTES IN BOOK:

BY: L. Wilson
ENGINEER - SURVEYOR
~~XXXXXXXX~~
Aide

DATE: 4/18/1977

ASSISTED BY: R. Rice

COPIES SENT TO:

FILED
RECEIVED *JK*
DEC 22 1980
COUNTY SURVEYOR
DOUGLAS COUNTY, ORE.

UNDER THE SUPERVISION OF:

REGISTERED PROFESSIONAL LAND SURVEYOR
Frank O. Williams
OREGON
JULY 12, 1968
FRANK O. WILLIAMS
0875

SEAL

PAGE 3

C. S. File No. 5812

36	31	32	33	34	35	36	31
1	6	5	4	3	2	1	6
12	7	8	9	10	11	12	7
13	18	17	16	15	14	13	18
24	19	20	21	22	23	24	19
25	30	29	28	27	26	25	30
36	31	32	33	34	35	36	31
1	6	5	4	3	2	1	6

WEYERHAEUSER COMPANY

CORNER REFERENCE METHOD CONSISTS OF:

A "W" NAIL DRIVEN THRU THE HOLE IN A BRASS DISC, INTO A NOTCH CUT LOW ON A TREE, STAMPED WITH THE OREGON REGISTERED LAND SURVEYOR OR PROFESSIONAL ENGINEER REGISTRATION NUMBER.

AN EMBOSSED ALUMINUM PLATE, NAILED HEAD HIGH ON SAME TREE WITH 8D ALUMINUM NAILS, WITH DISTANCE AND BEARING FROM THE "W" NAIL TO THE CORNER STAMPED ON IT.

