


PUBLIC LAND CORNERS

WEYERHAEUSER COMPANY
 SPRINGFIELD BRANCH

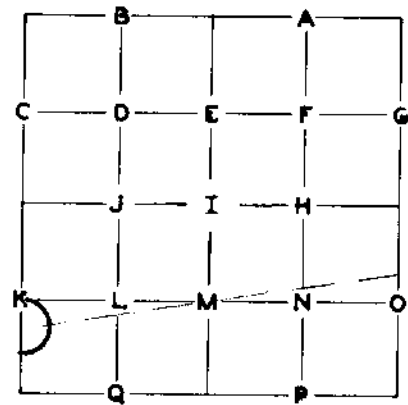

TOWNSHIP 24S RANGE 2W

SECTION 33 CORNER NW Tract 37

COUNTY Douglas OREGON

GLO SURVEY RECORD Civil No. 60-135 DATE: <u>1963</u> CORNER <u>Brass Cap</u>	PRESENT CONDITION - (DESCRIBE FULLY - USE PAGE 2 IF NEEDED FOR EXPLANATION.)																								
ACCESSORIES:																									
<table border="1" style="width:100%; border-collapse: collapse;"> <thead> <tr> <th style="width:15%;">BEARING-</th> <th style="width:15%;">LINKS-</th> <th style="width:15%;">FEET-</th> <th style="width:55%;"></th> </tr> </thead> <tbody> <tr> <td>10" Hemlock</td> <td>N81½E</td> <td>94</td> <td>62.0</td> </tr> <tr> <td>9" Yew</td> <td>S47½E</td> <td>102</td> <td>67.3</td> </tr> <tr> <td> </td> <td> </td> <td> </td> <td> </td> </tr> <tr> <td> </td> <td> </td> <td> </td> <td> </td> </tr> <tr> <td> </td> <td> </td> <td> </td> <td> </td> </tr> </tbody> </table>	BEARING-	LINKS-	FEET-		10" Hemlock	N81½E	94	62.0	9" Yew	S47½E	102	67.3													12" Hemlock - Scribing Visible - BT tag. 10" Yew - Scribing Visible - BT tag.
BEARING-	LINKS-	FEET-																							
10" Hemlock	N81½E	94	62.0																						
9" Yew	S47½E	102	67.3																						
SURVEY RECORD DATE:	PRESENT CONDITION:																								


CORNER ~~SET~~: brass cap as found MAG. DECL.: 20°

BEARING AND DISTANCE TO ABOVE IDENTIFIED SURVEY ACCESSORIES:

BEARING-	FEET-	SURVEY-	
N83E	62.6	1963	Center of tree measurement
S46E	68.3	1963	Center of tree measurement

#95 ✓

SECTION 33 TOWNSHIP 24S RANGE 2W

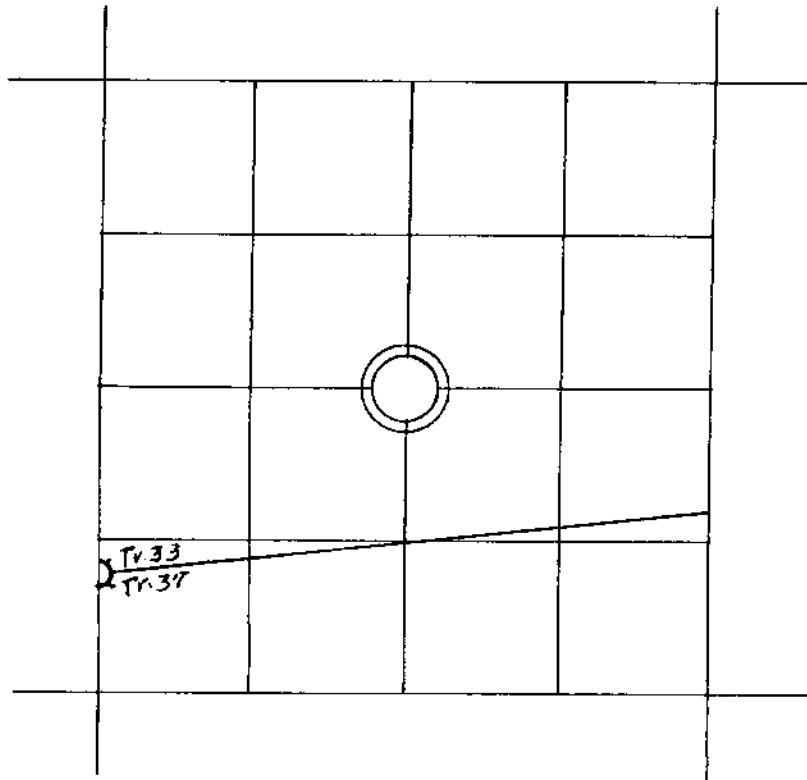

— // — // — // — LINE MARKED BY NOTCH CUT IN BLAZE.

○ — KNOWN CORNER.

⊗ — REFERENCED CORNER
BY WEYERHAEUSER
METHOD.

ACCESSORIES ADDED THIS DATE:

MAGNETIC DECLINATION 20°

	BEARING	FEET	ORIG. B. T.	"W" NAIL	PLATE	BRASS DISC
46" Fir	S42E	57.6	---	X	X	---
58" Fir	S87E	65.4	---	X	X	---

IDENTIFIED ON PHOTO:

INFORMATION ON LOCATION OF CORNER AS NOW SET:

GROUND COVER: Rhododendron

(USING FORM LINES SKETCH TOPOG AT CORNER ON PAGE 2 PLAT)

SLOPE FACES (GIVE BEARING IN DEGREES) S40°W ON MINUS (-) 40 %

NORTH: + 25%

FROM CORNER | SOUTH: - 25%

EAST: + 28%

WEST: - 30%

WORK DONE FOR W. CO. _____

FIELD NOTES IN BOOK: _____

BY: Glen McChesney DATE: 12/20/1975
Project ENGINEER - ~~SURVEYOR~~

ASSISTED BY: _____

COPIES SENT TO: _____

UNDER THE SUPERVISION OF:

REGISTERED PROFESSIONAL LAND SURVEYOR

Frank D. Williams

OREGON JULY 12, 1966 FRANK D. WILLIAMS 0075

SEAL

PAGE 3

C. S. File No. 5818

36	31	32	33	34	35	36	31
1	6	5	4	3	2	1	6
12	7	8	9	10	11	12	7
13	18	17	16	15	14	13	18
24	19	20	21	22	23	24	19
25	30	29	28	27	26	25	30
36	31	32	33	34	35	36	31
1	6	5	4	3	2	1	6

WEYERHAEUSER COMPANY

CORNER REFERENCE METHOD CONSISTS OF:

A "W" NAIL DRIVEN THRU THE HOLE IN A BRASS DISC, INTO A NOTCH CUT LOW ON A TREE, STAMPED WITH THE OREGON REGISTERED LAND SURVEYOR OR PROFESSIONAL ENGINEER REGISTRATION NUMBER.

AN EMBOSSED ALUMINUM PLATE, NAILED HEAD HIGH ON SAME TREE WITH 8D ALUMINUM NAILS, WITH DISTANCE AND BEARING FROM THE "W" NAIL TO THE CORNER STAMPED ON IT.

