

# PUBLIC LAND CORNERS

FILED  
RECEIVED *JK*  
DEC 22 1980


WEYERHAEUSER COMPANY  
SPRINGFIELD BRANCH

COUNTY SURVEYOR  
DOUGLAS COUNTY, ORE

TOWNSHIP 24S RANGE 3W

SECTION 5 CORNER S $\frac{1}{2}$

COUNTY Douglas OREGON

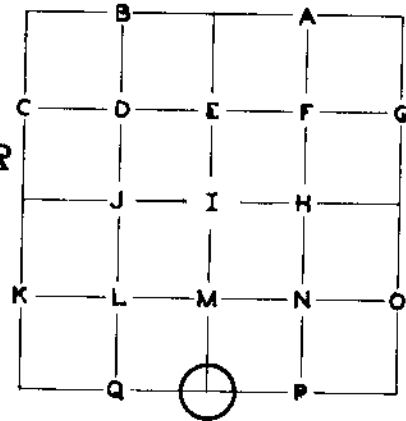

**GLO SURVEY RECORD**

DATE: 1950  
CORNER brass cap

PRESENT CONDITION - (DESCRIBE FULLY -  
USE PAGE 2 IF NEEDED FOR EXPLANATION.)

Found

**ACCESSORIES:**

	BEARING-	LINKS-	FEET-
15" Fir	N49 $\frac{1}{2}$ W	32	21.1
12" Cedar	S39E	28	18.5

20" Fir, face healed over; also Weyerhaeuser plate and scar of healed over W nail.  
18" Red Cedar, some scribing visible but much of scribing has weathered off; also Weyerhaeuser plate and square "W" nail.

Weyerhaeuser **SURVEY RECORD**  
DATE: 4/23/1953

PRESENT CONDITION:

Ehm - Price - McChesney.  
Found 1950 GLO brass cap and 2 BTs  
Referenced BTs with W nails and plates:  
18" Fir N49W 20.4'  
14" Cedar S43E 17.2'  
(Distances and bearings were to W nail)

As above.  
As above.

CORNER SET: Brass cap as found

MAG. DECL.: 20<sup>0</sup>

**BEARING AND DISTANCE TO ABOVE IDENTIFIED SURVEY ACCESSORIES:**

BEARING-	FEET-	SURVEY -	
N50W	21.1	1950	Center of tree measurement.
S42E	18.2	1950	Center of tree measurement.

#84 ✓



ACCESSORIES ADDED THIS DATE:

MAGNETIC DECLINATION 20°

	BEARING	FEET	ORIG. B.T.	"W" NAIL	PLATE	BRASS DISC
36" Fir	N33E	18.1	---	X	X	---
36" Fir	S88E	40.0	---	X	X	---

IDENTIFIED ON PHOTO:

INFORMATION ON LOCATION OF CORNER AS NOW SET:

GROUND COVER: Vine Maple, Salal.

(USING FORM LINES SKETCH TOPOG AT CORNER ON PAGE 2 PLAT)

SLOPE FACES (GIVE BEARING IN DEGREES) SLOW ON MINUS (-) 55 %

NORTH: + 45%

SOUTH: - 58%

EAST: + 50% 20' then descend.

WEST: Level 10' then + 15%.

FROM CORNER |

WORK DONE FOR W. CO.

FIELD NOTES IN BOOK:

BY: Glen McChesney DATE: 9/29/1977  
Project ENGINEER - ~~SURVEYOR~~

ASSISTED BY:

COPIES SENT TO:

FILED  
RECEIVED *VR*  
DEC 22 1980  
COUNTY SURVEYOR  
DOUGLAS COUNTY, ORE.

UNDER THE SUPERVISION OF:

REGISTERED PROFESSIONAL LAND SURVEYOR

*Frank O. Williams*

OREGON  
JULY 12, 1968  
FRANK O. WILLIAMS  
0875

SEAL

PAGE 3

C. S. File No. 5818

36	31	32	33	34	35	36	31
1	6	5	4	3	2	1	6
12	7	8	9	10	11	12	7
13	18	17	16	15	14	13	18
24	19	20	21	22	23	24	19
25	30	29	28	27	26	25	30
36	31	32	33	34	35	36	31
1	6	5	4	3	2	1	6

## WEYERHAEUSER COMPANY

CORNER REFERENCE METHOD CONSISTS OF:

A "W" NAIL DRIVEN THRU THE HOLE IN A BRASS DISC, INTO A NOTCH CUT LOW ON A TREE, STAMPED WITH THE OREGON REGISTERED LAND SURVEYOR OR PROFESSIONAL ENGINEER REGISTRATION NUMBER.

AN EMBOSSED ALUMINUM PLATE, NAILED HEAD HIGH ON SAME TREE WITH 8D ALUMINUM NAILS, WITH DISTANCE AND BEARING FROM THE "W" NAIL TO THE CORNER STAMPED ON IT.

