


PUBLIC LAND CORNERS

WEYERHAEUSER COMPANY
 SPRINGFIELD BRANCH

TOWNSHIP 24S RANGE 3W
 SECTION 6 (Only) CORNER W $\frac{1}{2}$
 COUNTY Douglas OREGON

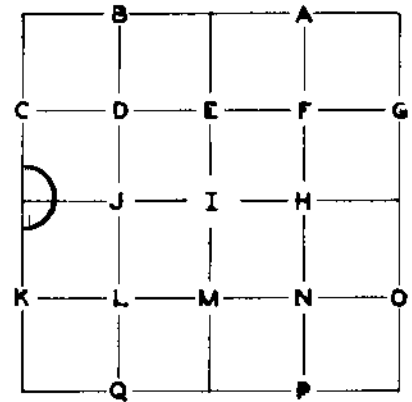


GLO SURVEY RECORD				PRESENT CONDITION - (DESCRIBE FULLY - USE PAGE 2 IF NEEDED FOR EXPLANATION.)	
CORNER <u>Brass Cap</u> DATE: <u>1950</u>				Found Brass Cap in place.	
ACCESSORIES:					
30" Fir	BEARING- N58°07'E	LINKS- 344	FEET- 227.0	40" Fir, scribing visible on partly healed face, BLM BT Tag.	
33" Inc. Cedar	S9E	630	419.8	42" Incense Cedar, faces healed over, BLM BT tag.	
SURVEY RECORD				PRESENT CONDITION:	
DATE:					

CORNER ~~SET~~ Brass cap as found MAG. DECL.: 20°

BEARING AND DISTANCE TO ABOVE IDENTIFIED SURVEY ACCESSORIES:


BEARING -	FEET -	SURVEY -	
N55E	---	1950	Read bearing but did not measure distance.
S7E	---	1950	Read bearing but did not measure distance.

SECTION 6 TOWNSHIP 24S RANGE 3W

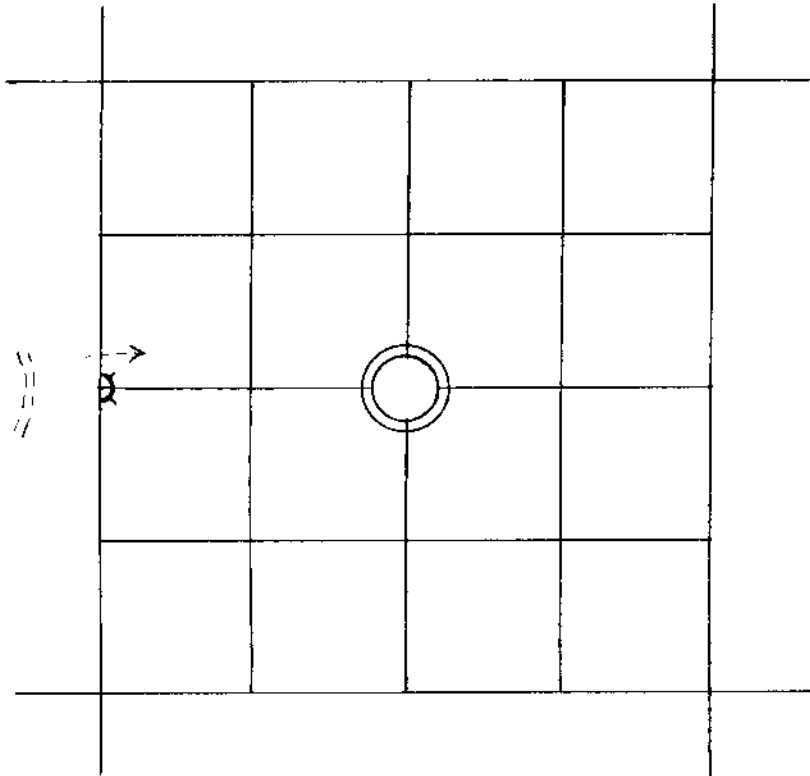

 LINE MARKED BY NOTCH CUT IN BLAZE.

 KNOWN CORNER.

 REFERENCED CORNER
BY WEYERHAEUSER
METHOD.

This corner is common only to Sec. 6; the $\frac{1}{4}$ corner for Section 1, T24S, R4W a
brass cap and 2 8Ts, now stumps were observed approximately N5E 440 ft.

ACCESSORIES ADDED THIS DATE:

MAGNETIC DECLINATION 20°

	BEARING	FEET	ORIG. B.T.	"W" NAIL	PLATE	BRASS DISC
12" Fir	N30E	52.3	---	X	X	---
8" Fir	S49E	22.0	---	Y	X	---

IDENTIFIED ON PHOTO:

INFORMATION ON LOCATION OF CORNER AS NOW SET:

GROUND COVER: Fern, 5-25 yr. fir reproduction

(USING FORM LINES SKETCH TOPOG AT CORNER ON PAGE 2 PLAT)

SLOPE FACES (GIVE BEARING IN DEGREES) S40F ON MINUS (-) 15 %

NORTH: Level for 40' then slight descent

FROM CORNER | SOUTH: - 5%

EAST: - 5%

WEST: + 5% 110' to dirt logging road

WORK DONE FOR W. CO. _____

FIELD NOTES IN BOOK: _____

BY: Glen McChesney DATE: 4/7/1976
Project ENGINEER - SURVEYOR XXXXXXXXXX

ASSISTED BY: _____

COPIES SENT TO: _____

UNDER THE SUPERVISION OF:

REGISTERED PROFESSIONAL LAND SURVEYOR

Frank O. Williams

OREGON
JULY 12, 1968
FRANK O. WILLIAMS
0875

SEAL

C. S. File No. 58/B

36	31	32	33	34	35	36	31
1	6	5	4	3	2	1	6
12	7	8	9	10	11	12	7
13	18	17	16	15	14	13	18
24	19	20	21	22	23	24	19
25	30	29	28	27	26	25	30
36	31	32	33	34	35	36	31
1	6	5	4	3	2	1	6

WEYERHAEUSER COMPANY

CORNER REFERENCE METHOD CONSISTS OF:

A "W" NAIL DRIVEN THRU THE HOLE IN A BRASS DISC, INTO A NOTCH CUT LOW ON A TREE, STAMPED WITH THE OREGON REGISTERED LAND SURVEYOR OR PROFESSIONAL ENGINEER REGISTRATION NUMBER.

AN EMBOSSED ALUMINUM PLATE, NAILED HEAD HIGH ON SAME TREE WITH 8D ALUMINUM NAILS, WITH DISTANCE AND BEARING FROM THE "W" NAIL TO THE CORNER STAMPED ON IT.

