


PUBLIC LAND CORNERS

WEYERHAEUSER COMPANY
 SPRINGFIELD BRANCH

TOWNSHIP 24S RANGE 3W
 SECTION 16 CORNER E₁
 COUNTY Douglas OREGON

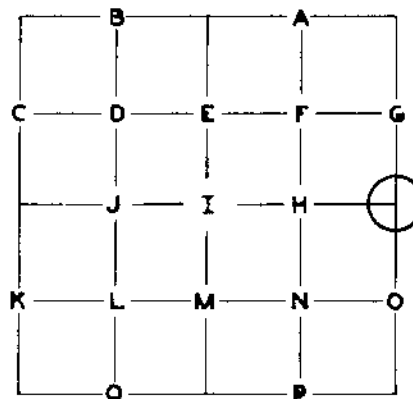

Old SURVEY RECORD DOUGLAS COUNTY RENEWAL #7 DATE: <u>Feb. 12, 1942</u> CORNER <u>set fir post</u>			PRESENT CONDITION - (DESCRIBE FULLY - USE PAGE 2 IF NEEDED FOR EXPLANATION.) <u>Rotted remains of scribed Fir post.</u>	
ACCESSORIES:				
	BEARING-	LINKS-	FEET-	
12" Cedar	N23E		36.8	Destroyed by old logging.
40" Cedar	S78W		22.5	42" Cedar stump, scribing visible.
Douglas County SURVEY RECORD DATE: <u>Sept. 1967</u> No trace of original. Found of CS #7 Renewal: Scribed Fir post and scribed 42" Cedar S82W 22.5'; no trace of NE BT. Set brass cap at corner. Scribed new BTs" 12" Cedar S89E 26.4' 12" Douglas-fir N4W 10.6'			PRESENT CONDITION: <u>As above.</u> <u>As above</u> <u>Found brass cap.</u> <u>12" Red Cedar scribing visible BT tag.</u> <u>14" D. Fir " " BT tag.</u>	

CORNER ~~XXXX~~ Brass cap as found MAG. DECL.: 20°

BEARING AND DISTANCE TO ABOVE IDENTIFIED SURVEY ACCESSORIES:

BEARING-	FEET-	SURVEY -	
S83W	24.0	1942	Center of stump measurement; 22.8' to scribed face.
S89E	26.4	1967	Center of tree measurement.
N4W	10.6	1967	Center of tree measurement.

#79 ✓

ACCESSORIES ADDED THIS DATE:

MAGNETIC DECLINATION 20°

	BEARING	FEET	ORIG. B.T.	"W" NAIL	PLATE	BRASS DISC
18" Douglas Fir	S41W	22.1	---	X	X	---
48" Fir Stump	N13W	74.0	---	X	X	---

IDENTIFIED ON PHOTO:

INFORMATION ON LOCATION OF CORNER AS NOW SET:

GROUND COVER: Second growth

(USING FORM LINES SKETCH TOPOG AT CORNER ON PAGE 2 PLAT)

SLOPE FACES (GIVE BEARING IN DEGREES) East ON MINUS (-) 10 %

NORTH: Level for 50' then slight descent.

FROM CORNER | SOUTH: + 5%. 1388' on decl. 20° to Sec. line marker pipe and board at North edge of 2900 road.

EAST: - 10%

WEST: + 20%

WORK DONE FOR W. CO. _____

FIELD NOTES IN BOOK: _____

BY: Glen McChesney DATE: May 6, 1976
Project ENGINEER - ~~XXXXXXXX~~

ASSISTED BY: _____

COPIES SENT TO: _____

UNDER THE SUPERVISION OF:

REGISTERED PROFESSIONAL LAND SURVEYOR

Frank O. Williams

OREGON
JULY 12, 1968
FRANK O. WILLIAMS
0875

SEAL

PAGE 3

C. S. File No. 5818

36	31	32	33	34	35	36	31
1	6	5	4	3	2	1	6
12	7	8	9	10	11	12	7
13	18	17	16	15	14	13	18
24	19	20	21	22	23	24	19
25	30	29	28	27	26	25	30
36	31	32	33	34	35	36	31
1	6	5	4	3	2	1	6

WEYERHAEUSER COMPANY

CORNER REFERENCE METHOD CONSISTS OF:

A "W" NAIL DRIVEN THRU THE HOLE IN A BRASS DISC, INTO A NOTCH CUT LOW ON A TREE, STAMPED WITH THE OREGON REGISTERED LAND SURVEYOR OR PROFESSIONAL ENGINEER REGISTRATION NUMBER.

AN EMBOSSED ALUMINUM PLATE, NAILED HEAD HIGH ON SAME TREE WITH 8D ALUMINUM NAILS, WITH DISTANCE AND BEARING FROM THE "W" NAIL TO THE CORNER STAMPED ON IT.

