

PUBLIC LAND CORNERS


FILED
RECEIVED

JUN 3 1981

WEYERHAEUSER COMPANY
SPRINGFIELD BRANCH

COUNTY SURVEYOR
DOUGLAS COUNTY, ORE.

TOWNSHIP 25S RANGE 2W
SECTION 4 CORNER SE Tract 37
COUNTY Douglas OREGON

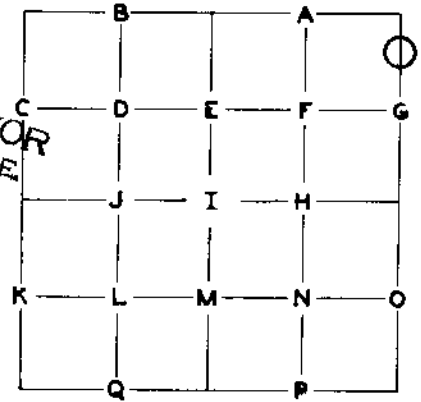


GLO SURVEY RECORD				PRESENT CONDITION - (DESCRIBE FULLY - USE PAGE 2 IF NEEDED FOR EXPLANATION.)
CORNER <u>Brass Cap</u> DATE: <u>1963</u>				
ACCESSORIES:				Found in place
12" Hemlock	BEARING- <u>S48W</u>	LINKS- <u>60</u>	FEET- <u>39.6</u>	
10" Hemlock	<u>N30W</u>	<u>54</u>	<u>35.6</u>	
SURVEY RECORD				PRESENT CONDITION:
DATE:				

CORNER SET: XXXX brass cap as found. MAG. DECL.: 20°E

BEARING AND DISTANCE TO ABOVE IDENTIFIED SURVEY ACCESSORIES:


BEARING- <u>S49W</u>	FEET- <u>39.6</u>	SURVEY - <u>1963</u>	Center of tree measurement.
<u>N37W</u>	<u>36.0</u>	<u>1963</u>	Center of tree measurement.

SECTION 4 TOWNSHIP 25S RANGE 2W

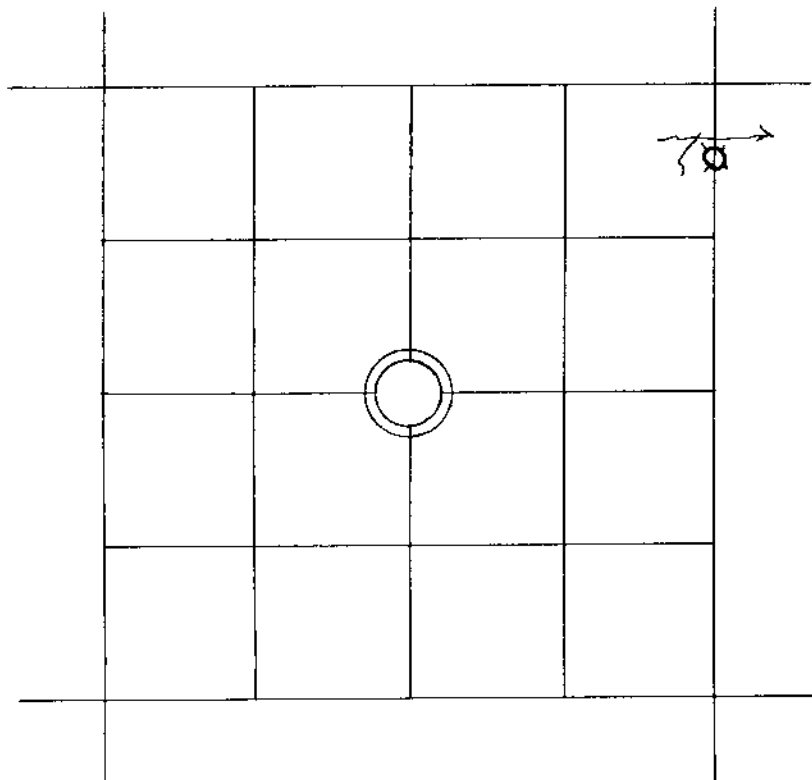

 LINE MARKED BY NOTCH CUT IN BLAZE.

 KNOWN CORNER.

 REFERENCED CORNER
BY WEYERHAEUSER
METHOD.

ACCESSORIES ADDED THIS DATE:

MAGNETIC DECLINATION 20°

(1 only)	BEARING	FEET	ORIG. B.T.	"W" NAIL	PLATE	BRASS DISC
72" Flr	S82W	9.4	---	X	X	---

IDENTIFIED ON PHOTO:

INFORMATION ON LOCATION OF CORNER AS NOW SET:

GROUND COVER: salal, fern

(USING FORM LINES SKETCH TOPOG AT CORNER ON PAGE 2 PLAT)

SLOPE FACES (GIVE BEARING IN DEGREES) N80°E ON MINUS (-) 10 %

NORTH: - 50% for 50', then descent steepens another 75' to creek course easterly.

FROM CORNER | SOUTH: + 15% for 35', then ascent steepens; approx. 430' to logging road.

EAST: - 10%.

WEST: + 15%

FILED
RECEIVED

JUN 3 1981

COUNTY SURVEYOR
DOUGLAS COUNTY, ORE.

WORK DONE FOR W. CO. _____

FIELD NOTES IN BOOK: _____

BY: Glen McChesney DATE: 8/1/1977
Project ENGINEER - SURVEYOR

UNDER THE SUPERVISION OF:

REGISTERED
PROFESSIONAL
LAND SURVEYOR

Frank O. Williams

OREGON
JULY 12, 1968
FRANK O. WILLIAMS
0878

ASSISTED BY: _____

COPIES SENT TO: _____

SEAL PAGE 3

C. S. File No. 5818

36	31	32	33	34	35	36	31
1	6	5	4	3	2	1	6
12	7	8	9	10	11	12	7
13	18	17	16	15	14	13	18
24	19	20	21	22	23	24	19
25	30	29	28	27	26	25	30
36	31	32	33	34	35	36	31
1	6	5	4	3	2	1	6

WEYERHAEUSER COMPANY

CORNER REFERENCE METHOD CONSISTS OF:

A "W" NAIL DRIVEN THRU THE HOLE IN A BRASS DISC, INTO A NOTCH CUT LOW ON A TREE, STAMPED WITH THE OREGON REGISTERED LAND SURVEYOR OR PROFESSIONAL ENGINEER REGISTRATION NUMBER.

AN EMBOSSED ALUMINUM PLATE, NAILED HEAD HIGH ON SAME TREE WITH 8D ALUMINUM NAILS, WITH DISTANCE AND BEARING FROM THE "W" NAIL TO THE CORNER STAMPED ON IT.

