

RESTORED CORNER

WEYERHAEUSER COMPANY

SPRINGFIELD BRANCH

Douglas County

CORNER CW 1/16 Sec 8 T. 25 S. R. 2 W. WM.  
NOTES DATED: 11/10/1958 BY: V.W. Hasford RPLS No. 253  
CORNER: 1 1/2" Iron Pipe  
ACCESSORIES: 24" Hemlock N21 1/2 E 31.0; 12" Hemlock S28 1/2 E 5.8'  
Survey For Evans Products Co.

REESTABLISHMENT NOTES DATED: 7/29/59 BY: Glen McChesney For Weyerhaeuser Co.  
EVIDENCE RECOVERED: Found Hasford's 1 1/2" Iron Pipe & 2 B.T.s:  
24" Hem. N21 E 31.0, Scribed CW 1/16 S8 BT 25.3 to face  
12" Hem. S28 E 5.0, Scribed CW 1/16 S8 BT 25.3 to face  
CORNER: Hasford's Pipe as found  
ACCESSORIES ESTABLISHED: 12" Hemlock S27 E 5.6' W nail, Plate  
4 1/2" Fir Stump 8' high N30 W 27.2' W nail, Plate  
Under the Supervision of L. Calder - Reg. Eng. No 2149

REESTABLISHMENT NOTES DATED: BY:  
EVIDENCE RECOVERED:

CORNER SET:  
ACCESSORIES ESTABLISHED:

REESTABLISHMENT NOTES DATED: BY:  
EVIDENCE RECOVERED:

CORNER SET:  
ACCESSORIES ESTABLISHED:


REMONUMENTATION

DATE: 8/11/1980 BY: Glen McChesney TITLE: Project Engineer FIRM: Weyerhaeuser Contract  
EVIDENCE RECOVERED: Hasford's Pipe in place; Down rotted 24" Hemlock N21 E 31.0;  
down, rotted 12" Hemlock S28 E 5.0, Scribing & W nail. Also found W nail,  
Plate gone, in rotted wood of 4 1/2" x 9" broken stub N30 W 27.2.

CORNER: Hasford's Pipe as found

ACCESSORIES ESTABLISHED: W nail & plates on: 8" D. Fir N24 W 2.4';  
6" Incense Cedar S72 1/2 W 15.9  
Bearings & distances to W nail, destination 20° E

OTHER INFORMATION: Slope: 540 E - 15%; North + 15%; South - 20%;  
East - 15%; West + 20% (Estimated)

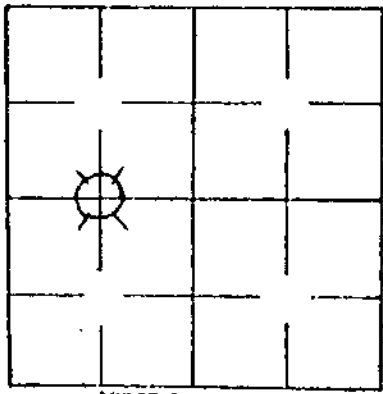

SECTION DIAGRAM

FILED  
RECEIVED 7/8  
DEC 22 1980  
COUNTY SURVEYOR  
DOUGLAS COUNTY, ORE

SKETCH

C. S. File No. 58/8-33

SEAL  
REGISTERED PROFESSIONAL LAND SURVEYOR  
Frank O. Williams  
OREGON JULY 12, 1988  
FRANK O. WILLIAMS  
0875  
ORS 672.025