


SECTION 18 TOWNSHIP 25S RANGE 2W

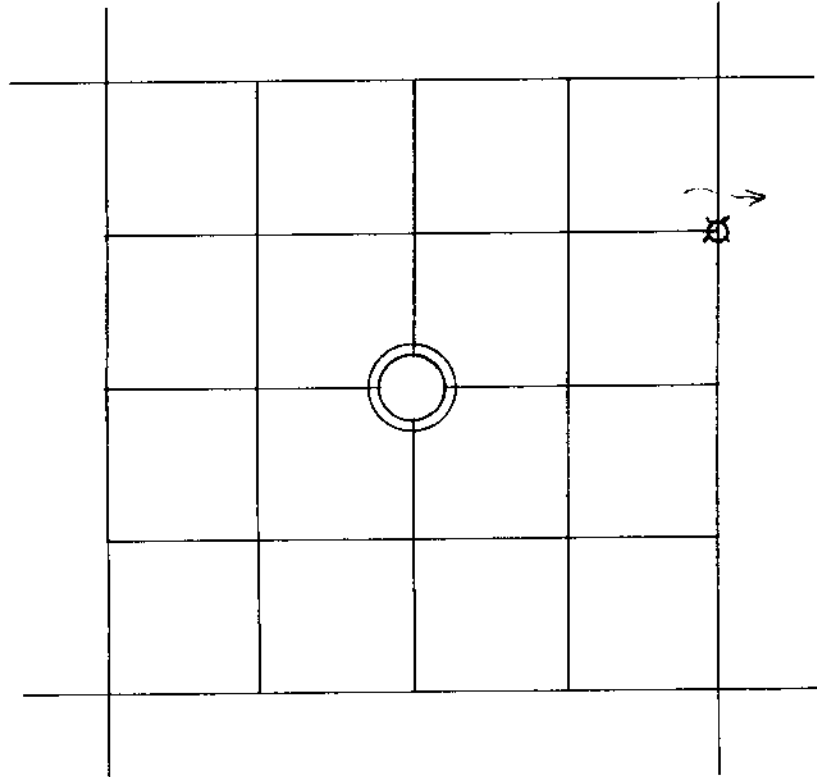

—//—//—//— LINE MARKED BY NOTCH CUT IN BLAZE.

○ KNOWN CORNER.

⊗ REFERENCED CORNER BY WEYERHAEUSER METHOD.

The square "W" nail on a 20" Hemlock with Weyerhaeuser plate, previously referred to a staff compass corner now superseded by the corner as set by this Baughman Survey. This plate previously read "N19E 29.8' "; this was scratched through and "N20E 24.9" scratched in by Baughman Survey. I have obliterated these marks and have remarked this same plate "N22E 23.9" as a reference to the Baughman Corner.

The corner point for the spurious staff compass corner is a squared, down, rotted 4" Hemlock and bears N22E 6.0' from the Baughman Corner.

ACCESSORIES ADDED THIS DATE: 4/21/1976

MAGNETIC DECLINATION 20⁰

	BEARING	FEET	ORIG. B.T.	"W" NAIL	PLATE	BRASS DISC
36" Fir	N55½W	31.0	---	X	X	---
20" Hemlock	S22W	23.9	See Page 2	Old Square	Old W. Co.	---

IDENTIFIED ON PHOTO:

INFORMATION ON LOCATION OF CORNER AS NOW SET:

GROUND COVER: Fern, small Red Cedar, rocky.

(USING FORM LINES SKETCH TOPOG AT CORNER ON PAGE 2 PLAT)

SLOPE FACES (GIVE BEARING IN DEGREES) N20E ON MINUS (-) 45 %

NORTH: - 40%

SOUTH: + 40%

EAST: - 5%

WEST: + 15%

WORK DONE FOR W. CO. _____

FIELD NOTES IN BOOK: _____

BY: Glen McChesney DATE: 4/21/1976
Project ENGINEER - ~~SURVEYOR~~

ASSISTED BY: _____

FILED
RECEIVED *rl*

DEC 22 1980

COUNTY SURVEYOR
DOUGLAS COUNTY, ORE.

COPIES SENT TO: _____

UNDER THE SUPERVISION OF:

REGISTERED PROFESSIONAL LAND SURVEYOR

Frank O. Williams

OREGON
JULY 12, 1968
FRANK O. WILLIAMS
0875

SEAL

PAGE 3

U. S. File No. 5818

36	31	32	33	34	35	36	31
1	6	5	4	3	2	1	6
12	7	8	9	10	11	12	7
13	18	17	16	15	14	13	18
24	19	20	21	22	23	24	19
25	30	29	28	27	26	25	30
36	31	32	33	34	35	36	31
1	6	5	4	3	2	1	6

WEYERHAEUSER COMPANY

CORNER REFERENCE METHOD CONSISTS OF:

A "W" NAIL DRIVEN THRU THE HOLE IN A BRASS DISC, INTO A NOTCH CUT LOW ON A TREE, STAMPED WITH THE OREGON REGISTERED LAND SURVEYOR OR PROFESSIONAL ENGINEER REGISTRATION NUMBER.

AN EMBOSSED ALUMINUM PLATE, NAILED HEAD HIGH ON SAME TREE WITH 8D ALUMINUM NAILS, WITH DISTANCE AND BEARING FROM THE "W" NAIL TO THE CORNER STAMPED ON IT.

