


PUBLIC LAND CORNERS

WEYERHAEUSER COMPANY
 SPRINGFIELD BRANCH

TOWNSHIP 25S RANGE 2W
 SECTION 24 CORNER CW1/16
 COUNTY Douglas OREGON

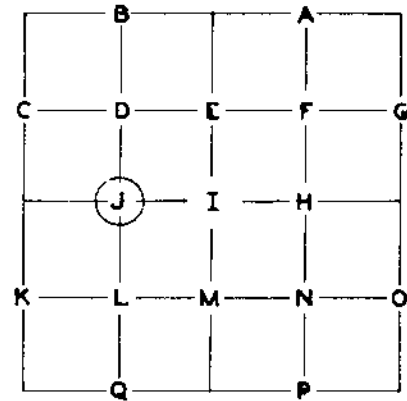

GLO SURVEY RECORD DATE: _____ CORNER _____	PRESENT CONDITION - (DESCRIBE FULLY - USE PAGE 2 IF NEEDED FOR EXPLANATION.)
--	---


ACCESSORIES:			
	BEARING-	LINKS-	FEET-

V. Hosford SURVEY RECORD DATE: <u>1955</u> 3" scribed Hemlock post and scribed following BTs: 26" Fir N24° E 25.8' 20" Fir S62½° W 21.2'	PRESENT CONDITION: _____ Found scribed Hemlock post in place. 28" Fir, scribing visible 20" Fir, scribing visible
---	--

CORNER SET: Hemlock post as found MAG. DECL.: 20°

BEARING AND DISTANCE TO ABOVE IDENTIFIED SURVEY ACCESSORIES:			
BEARING-	FEET-	SURVEY -	
N23° E	25.8	1955	Face measurement
S62° W	21.2	1955	Face measurement

SECTION 24 TOWNSHIP 25S RANGE 2W

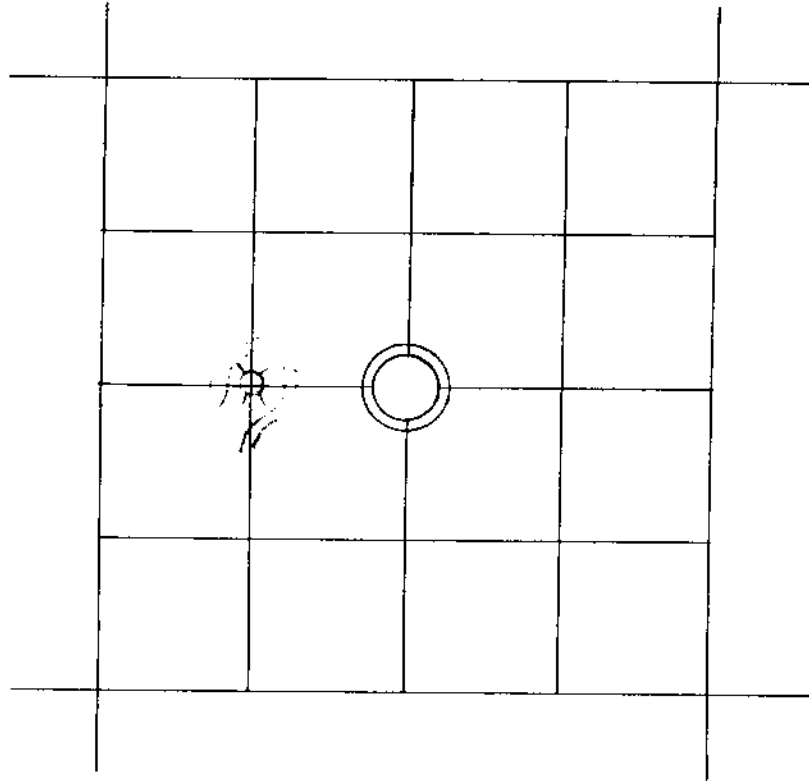

—//—//—//— LINE MARKED BY NOTCH CUT IN BLAZE.

○--- KNOWN CORNER.

⊗--- REFERENCED CORNER
BY WEYERHAEUSER
METHOD.

ACCESSORIES ADDED THIS DATE:

MAGNETIC DECLINATION 20°

	BEARING	FEET	ORIG. B.T.	"W" NAIL	PLATE	BRASS DISC
28" Fir	N23° E	25.7	Hosford	X	X	-
20" Fir	S62° W	21.1	Hosford	X	X	-

IDENTIFIED ON PHOTO:

INFORMATION ON LOCATION OF CORNER AS NOW SET:

GROUND COVER: Rhododendron

(USING FORM LINES SKETCH TOPOG AT CORNER ON PAGE 2 PLAT)

SLOPE FACES (GIVE BEARING IN DEGREES) N45° W ON MINUS (-) 50 %

NORTH: -15%

SOUTH: +15%

EAST: +20%

WEST: -25%

FROM CORNER |

WORK DONE FOR W. CO.

FIELD NOTES IN BOOK: _____

BY: Glen McChesney DATE 10/05/71

P.E. - ENGINEER - SURVEYOR

ASSISTED BY: _____

COPIES SENT TO: _____

UNDER THE SUPERVISION OF:

SEAL

PAGE 3

C. & P. No. 5818

36	31	32	33	34	35	36	31
1	6	5	4	3	2	1	6
12	7	8	9	10	11	12	7
13	18	17	16	15	14	13	18
24	19	20	21	22	23	24	19
25	30	29	28	27	26	25	30
36	31	32	33	34	35	36	31
1	6	5	4	3	2	1	6

WEYERHAEUSER COMPANY

CORNER REFERENCE METHOD CONSISTS OF:

A "W" NAIL DRIVEN THRU THE HOLE IN A BRASS DISC, INTO A NOTCH CUT LOW ON A TREE, STAMPED WITH THE OREGON REGISTERED LAND SURVEYOR OR PROFESSIONAL ENGINEER REGISTRATION NUMBER.

AN EMBOSSED ALUMINUM PLATE, NAILED HEAD HIGH ON SAME TREE WITH 8D ALUMINUM NAILS, WITH DISTANCE AND BEARING FROM THE "W" NAIL TO THE CORNER STAMPED ON IT.

