

PUBLIC LAND CORNERS

WEYERHAEUSER COMPANY

SPRINGFIELD BRANCH

TOWNSHIP	25S	RANGE	2W
SECTION	31 (only)	CORNER	S $\frac{1}{2}$
COUNTY	Douglas	OREGON	

Found in field: Bureau of Land Management Cadastral Survey 1972
Brass cap and 2 scribed bearing trees.


20" Hemlock N41E 86.1' (plate reads 132 lks. S41E).
 10" Hemlock N27W 48.3' (plate reads 73 lks. S31 $\frac{1}{2}$ E).

Brass cap referenced with plates and W nails on:

56" Fir N41W 54.0'
 60" Fir N41W 40.9'

Also drove 5/8" x 40" rebar 2' North of brass cap and 1" x 36" pipe
2.0' East of brass cap, both driven down flush with ground.

A Baughman Surveying Service March 1976 survey shows the brass cap
to be 0.67' South of the North line of Sec. 6, T26S, R2W.

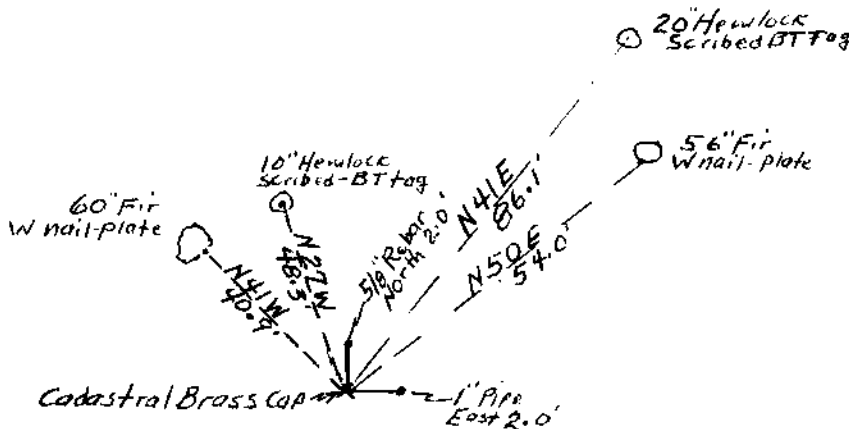

**REGISTERED
 PROFESSIONAL
 LAND SURVEYOR**

Frank O. Williams

**OREGON
 JULY 12, 1968
 FRANK O. WILLIAMS
 0875**

Work done for Weyerhaeuser Company
 By: Glen McChesney
 Date: 4/28/76

C. S. File No. 5818-41

*10