


PUBLIC LAND CORNERS

WEYERHAEUSER COMPANY
 SPRINGFIELD BRANCH

TOWNSHIP 25S RANGE 2W

SECTION 31 CORNER SE (Closing)

COUNTY Douglas OREGON

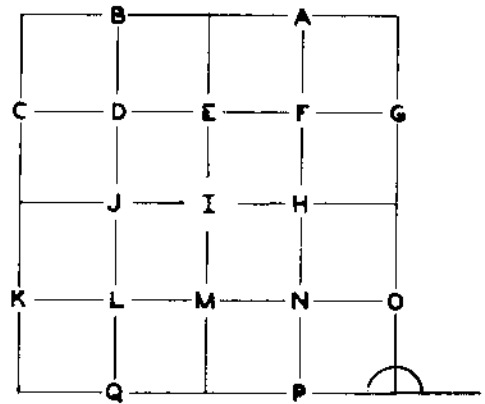

X1000 SURVEY RECORD VERN HOSFORD CS #54 DATE: <u>October 1960</u>			PRESENT CONDITION - (DESCRIBE FULLY - USE PAGE 2 IF NEEDED FOR EXPLANATION.)
CORNER <u>No trace of Original</u> <u>Set 4" Fir post</u>			
ACCESSORIES:			Down
	BEARING-	LINKS-	FEET-
21" Cedar	N67E	20.3	22" Incense Cedar, scribing visible.
25" Cedar	N68W	27.8	28" Incense Cedar, face healed over.

Douglas Co. SURVEY RECORD DATE: <u>1972</u>			PRESENT CONDITION:
CS Renewal #91 Found: 21" Cedar N67E 20.3' scribing visible. 28" Cedar N68W 27.8' face healed. Found Hosford's 4" Fir post. Set Douglas County brass cap and tagged Hosford's BTs.			
			As above.
			As above
			As above.
			Found brass cap and BT tags.


CORNER ~~Mark~~ Douglas County brass cap MAG. DECL: 20°

BEARING AND DISTANCE TO ABOVE IDENTIFIED SURVEY ACCESSORIES:

BEARING-	FEET-	SURVEY-	
N68E	21.1	Hosford	Center of tree (20.3' to face).
N68W	28.3	"	" " " (27.7' to face).

#10.3 ✓

SECTION 31 TOWNSHIP 25S RANGE 2W

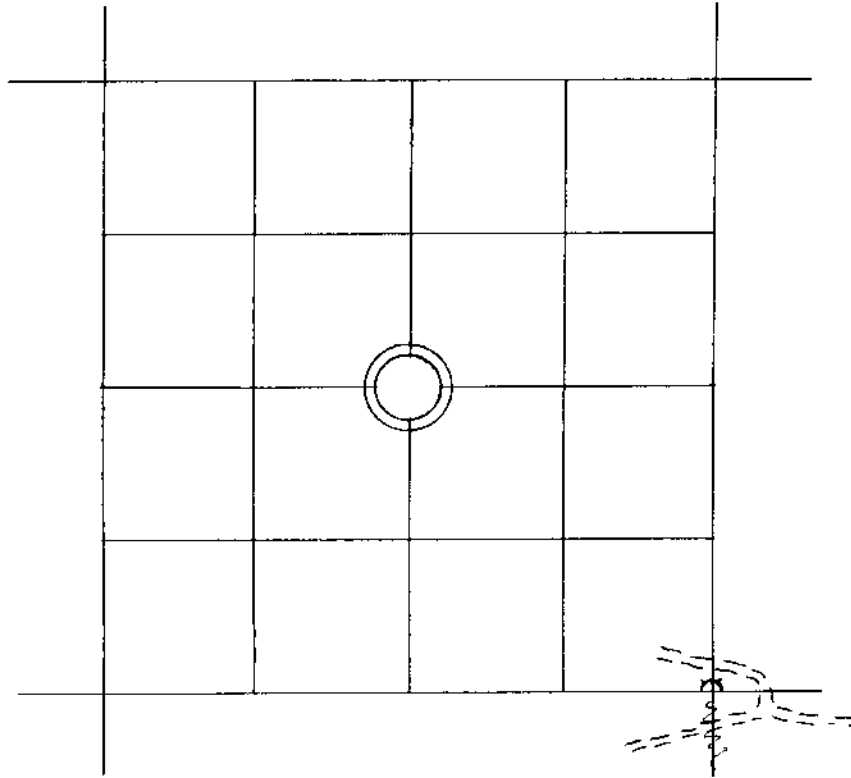

—//—//—//— LINE MARKED BY NOTCH CUT IN BLAZE.

○...KNOWN CORNER.

⊗...REFERENCED CORNER
BY WEYERHAEUSER
METHOD.

This is a closing corner and common only to Sections 31 and 32,
T25S, R2W

ACCESSORIES ADDED THIS DATE:

MAGNETIC DECLINATION 20°

1 Only	BEARING	FEET	ORIG. B.T.	"W" NAIL	PLATE	BRASS DISC
48" Fir	S70W	12.3	----	X	X	---

IDENTIFIED ON PHOTO:

INFORMATION ON LOCATION OF CORNER AS NOW SET:

GROUND COVER: Salal

(USING FORM LINES SKETCH TOPOG AT CORNER ON PAGE 2 PLAT)

SLOPE FACES (GIVE BEARING IN DEGREES) _____ ON MINUS (-) _____ %

NORTH: + 5% 20' to top of E-W ridge; approx. 80' to E rock road.

FROM CORNER | SOUTH: - 15% approx. 180' to rock road.

EAST: + 12% approx. 150' to rock road.

WEST: - 7%

WORK DONE FOR W. CO. _____

FIELD NOTES IN BOOK: _____

BY: Glen McChesney DATE: April 28, 1976
Project ENGINEER - SURVEYOR

UNDER THE SUPERVISION OF:

REGISTERED PROFESSIONAL LAND SURVEYOR

Frank O. Williams

OREGON
JULY 12, 1908
FRANK O. WILLIAMS
0875

ASSISTED BY: _____

COPIES SENT TO: _____

SEAL

58/B

36	31	32	33	34	35	36	31
1	6	5	4	3	2	1	6
12	7	8	9	10	11	12	7
13	18	17	16	15	14	13	18
24	19	20	21	22	23	24	19
25	30	29	28	27	26	25	30
36	31	32	33	34	35	36	31
1	6	5	4	3	2	1	6

WEYERHAEUSER COMPANY

CORNER REFERENCE METHOD CONSISTS OF:

A "W" NAIL DRIVEN THRU THE HOLE IN A BRASS DISC, INTO A NOTCH CUT LOW ON A TREE, STAMPED WITH THE OREGON REGISTERED LAND SURVEYOR OR PROFESSIONAL ENGINEER REGISTRATION NUMBER.

AN EMBOSSED ALUMINUM PLATE, NAILED HEAD HIGH ON SAME TREE WITH 8D ALUMINUM NAILS, WITH DISTANCE AND BEARING FROM THE "W" NAIL TO THE CORNER STAMPED ON IT.

