


PUBLIC LAND CORNERS

RECEIVED *JK*
DEC 22 1980

WEYERHAEUSER COMPANY
SPRINGFIELD BRANCH

COUNTY SURVEYOR
DOUGLAS COUNTY, ORE.

TOWNSHIP 25S RANGE 2W
SECTION 36 CORNER E $\frac{1}{4}$
COUNTY Douglas OREGON

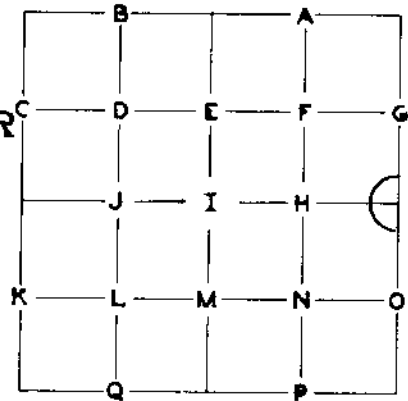

<p>GLO SURVEY RECORD</p> <p>CORNER <u>fir post</u> DATE: <u>1900 Resurvey</u></p> <p>ACCESSORIES:</p> <table border="1" style="width:100%; border-collapse: collapse;"> <thead> <tr> <th></th> <th>BEARING-</th> <th>LINKS-</th> <th>FEET-</th> </tr> </thead> <tbody> <tr> <td>(1) 14" Post</td> <td>S88E</td> <td>22</td> <td>14.5</td> </tr> <tr> <td>(2) 6" Hemlock</td> <td>S55W</td> <td>22</td> <td>14.5</td> </tr> </tbody> </table>		BEARING-	LINKS-	FEET-	(1) 14" Post	S88E	22	14.5	(2) 6" Hemlock	S55W	22	14.5	<p>PRESENT CONDITION - (DESCRIBE FULLY - USE PAGE 2 IF NEEDED FOR EXPLANATION.)</p> <p>No trace of original post</p> <p>No trace 10" Hemlock - scribing visible</p>
	BEARING-	LINKS-	FEET-										
(1) 14" Post	S88E	22	14.5										
(2) 6" Hemlock	S55W	22	14.5										
<p><i>#125 T25-1</i> <i>#81</i> Douglas Co. SURVEY RECORD DATE: <u>May 1967</u> CS File 52/30 Found scribe marks on SW BT, a</p> <table border="1" style="width:100%; border-collapse: collapse;"> <tbody> <tr> <td>(2) 10" Hemlock S55W 14.5'</td> </tr> <tr> <td>Set brass cap, new BTs:</td> </tr> <tr> <td>(3) 17" Hemlock S47W 35.7'</td> </tr> <tr> <td>(4) 8" Hemlock N46W 20.8'</td> </tr> </tbody> </table>	(2) 10" Hemlock S55W 14.5'	Set brass cap, new BTs:	(3) 17" Hemlock S47W 35.7'	(4) 8" Hemlock N46W 20.8'	<p>PRESENT CONDITION:</p> <p>As above Found Douglas Co. brass cap 18" Hemlock; scribing visible 8" dead hemlock, scribing visible Douglas County BT tags on these BTs</p>								
(2) 10" Hemlock S55W 14.5'													
Set brass cap, new BTs:													
(3) 17" Hemlock S47W 35.7'													
(4) 8" Hemlock N46W 20.8'													


CORNER SET: ~~XXX~~ Douglas County brass cap as found MAG. DECL.: 20°E

BEARING AND DISTANCE TO ABOVE IDENTIFIED SURVEY ACCESSORIES:

BEARING-	FEET-	SURVEY-	
(2) S55W	14.5	1900	Center measurement
(3) S47W	35.7	1967	Center measurement
(4) N46W	20.8	1967	Center measurement


#112 T25-2
#151 T25-1

SECTION 36 TOWNSHIP 25S RANGE 2W

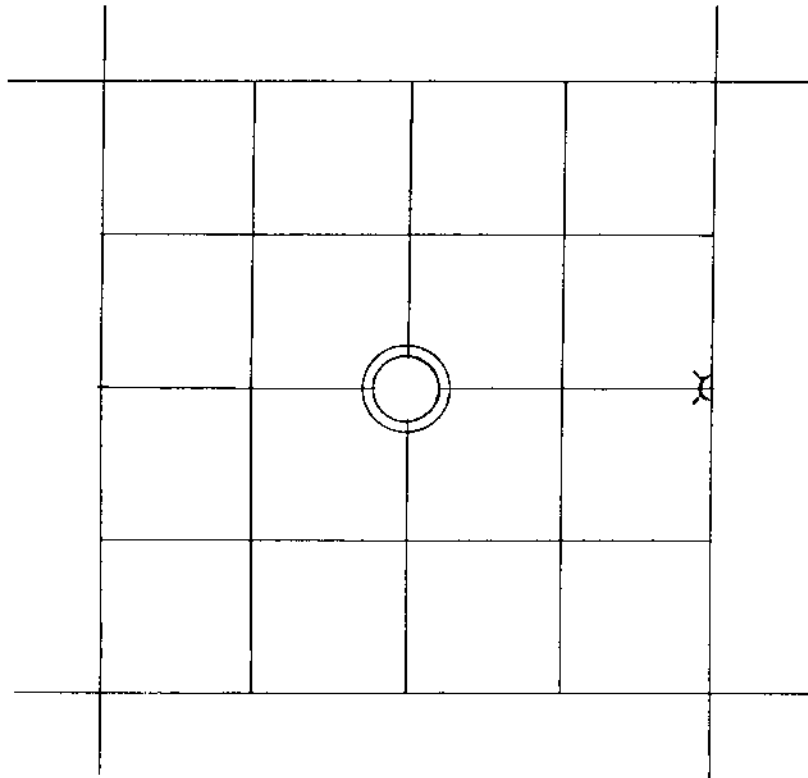

 LINE MARKED BY NOTCH CUT IN BLAZE.

 KNOWN CORNER.

 REFERENCED CORNER
BY WEYERHAEUSER
METHOD.

The closing corner for Sec. 31, T25S, R1W and Sec. 6, T26S, R1W
is approx. 401' South and 2' East.

ACCESSORIES ADDED THIS DATE:

MAGNETIC DECLINATION 20°

	BEARING	FEET	ORIG. B.T.	"W" NAIL	PLATE	BRASS DISC
48" Fir	N15W	17.8	---	X	X	---
48" Red Cedar	S51W	37.3	---	X	X	---

IDENTIFIED ON PHOTO:

INFORMATION ON LOCATION OF CORNER AS NOW SET:

GROUND COVER:

(USING FORM LINES SKETCH TOPOG AT CORNER ON PAGE 2 PLAT)

SLOPE FACES (GIVE BEARING IN DEGREES) SW ON MINUS (-) 20 %

NORTH: + 10% 150' to creek course SW

SOUTH: - 10%

EAST: + 30%

WEST: - 30% 50' to creek course South

FROM CORNER |

WORK DONE FOR W. CO.

FIELD NOTES IN BOOK:

BY: Glen McChesney DATE: Labor Day 1975
Project ENGINEER - SURVEYOR

ASSISTED BY:

FILED
RECEIVED *JL*
DEC 22 1980

COPIES SENT TO:

COUNTY SURVEYOR
DOUGLAS COUNTY, ORE.

UNDER THE SUPERVISION OF:

REGISTERED PROFESSIONAL LAND SURVEYOR

Frank O. Williams

OREGON
JUL 12, 1968
FRANK O. WILLIAMS
0875

SEAL

C. S. File No. 58/B

36	31	32	33	34	35	36	31
1	6	5	4	3	2	1	6
12	7	8	9	10	11	12	7
13	18	17	16	15	14	13	18
24	19	20	21	22	23	24	19
25	30	29	28	27	26	25	30
36	31	32	33	34	35	36	31
1	6	5	4	3	2	1	6

WEYERHAEUSER COMPANY

CORNER REFERENCE METHOD CONSISTS OF:

A "W" NAIL DRIVEN THRU THE HOLE IN A BRASS DISC, INTO A NOTCH CUT LOW ON A TREE, STAMPED WITH THE OREGON REGISTERED LAND SURVEYOR OR PROFESSIONAL ENGINEER REGISTRATION NUMBER.

AN EMBOSSED ALUMINUM PLATE, NAILED HEAD HIGH ON SAME TREE WITH 8D ALUMINUM NAILS, WITH DISTANCE AND BEARING FROM THE "W" NAIL TO THE CORNER STAMPED ON IT.

