


# PUBLIC LAND CORNERS

WEYERHAEUSER COMPANY  
 SPRINGFIELD BRANCH

TOWNSHIP 26S RANGE 2W  
 SECTION 6 (only) CORNER N $\frac{1}{4}$   
 COUNTY Douglas OREGON

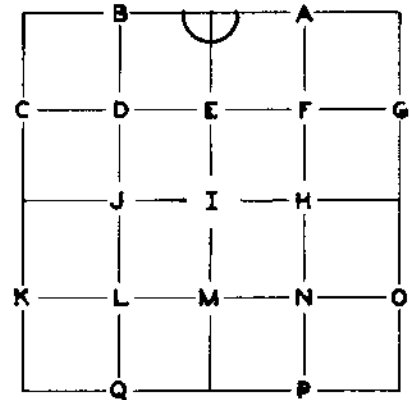

GLO SURVEY RECORD				PRESENT CONDITION - (DESCRIBE FULLY - USE PAGE 2 IF NEEDED FOR EXPLANATION.)
DATE: <u>1914</u>				
CORNER <u>Cedar Post</u>				
ACCESSORIES:				
	BEARING-	LINKS-	FEET-	
40" Fir	S31E	39	25.7	56" Fir, old healed face.
36" Fir	S54W	36	23.8	44" Fir, lower face had been opened, now pitched over.
Douglas County SURVEY RECORD				PRESENT CONDITION:
DATE: <u>1967</u> <u>Renewal</u>				
Found remains of Cedar post and of original BTs found:				
60" Fir	S31E 25.7'	Good Scar.		
50" Fir	S54W 23.8'	Found scribed "B"		
Set Douglas Co. Brass cap, new BTs:				Found brass cap.
7" D. Fir	S32W 14.3'	"1/4 CS BT"		8" Fir, down, scribing and tag visible.
14" D. Fir	S54E 15.2'	"1/4 CS BT"		16" Fir, scribing and tag visible.

CORNER ~~32W~~ Douglas County Brass Cap MAG. DECL.: 20°

BEARING AND DISTANCE TO ABOVE IDENTIFIED SURVEY ACCESSORIES:

BEARING-	FEET-	SURVEY-	
S32E	25.7	1914	Center of tree measurement.
S54W	23.8	1914	Center of tree measurement.
S32W	14.3	1967	to root hole.
S54E	15.2	1967	Center of tree measurement.



ACCESSORIES ADDED THIS DATE:

MAGNETIC DECLINATION 20°

	BEARING	FEET	ORIG. B.T.	"W" NAIL	PLATE	BRASS DISC
56" Fir	S33E	22.7	1914	X	X	---
44" Fir	S54W	21.8	1914	X	X	---

IDENTIFIED ON PHOTO:

INFORMATION ON LOCATION OF CORNER AS NOW SET:

GROUND COVER: Salal

(USING FORM LINES SKETCH TOPOG AT CORNER ON PAGE 2 PLAT)

SLOPE FACES (GIVE BEARING IN DEGREES) \_\_\_\_\_ ON MINUS (-) \_\_\_\_\_ %

NORTH: + 32%

SOUTH: - 18%

EAST: + 25%

WEST: - 32%

WORK DONE FOR W. CO. \_\_\_\_\_

FIELD NOTES IN BOOK: \_\_\_\_\_

BY: Glen McChesney DATE: 4/28/1976  
Project ENGINEER - SURVEYOR

UNDER THE SUPERVISION OF:

REGISTERED PROFESSIONAL LAND SURVEYOR

*Frank O. Williams*

OREGON  
JULY 12, 1968  
FRANK O. WILLIAMS  
0875

ASSISTED BY: \_\_\_\_\_

COPIES SENT TO: \_\_\_\_\_

36	31	32	33	34	35	36	31
1	6	5	4	3	2	1	6
12	7	8	9	10	11	12	7
13	18	17	16	15	14	13	18
24	19	20	21	22	23	24	19
25	30	29	28	27	26	25	30
36	31	32	33	34	35	36	31
1	6	5	4	3	2	1	6

## WEYERHAEUSER COMPANY

CORNER REFERENCE METHOD CONSISTS OF:

A "W" NAIL DRIVEN THRU THE HOLE IN A BRASS DISC, INTO A NOTCH CUT LOW ON A TREE, STAMPED WITH THE OREGON REGISTERED LAND SURVEYOR OR PROFESSIONAL ENGINEER REGISTRATION NUMBER.

AN EMBOSSED ALUMINUM PLATE, NAILED HEAD HIGH ON SAME TREE WITH 8D ALUMINUM NAILS, WITH DISTANCE AND BEARING FROM THE "W" NAIL TO THE CORNER STAMPED ON IT.

