


CERTIFIED RECORD OF LAND CORNER MONUMENTATION

History of original corner establishment:

NONE

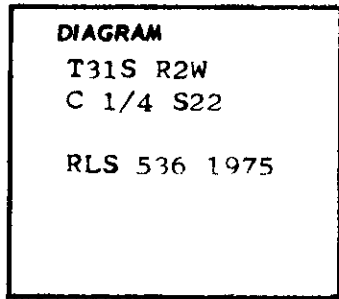

Description of corner evidence found:

NONE



Description of monument and accessories established to perpetuate the original location of this corner

I set a 30 inch long, 2 1/2 inch diameter galvanized iron pipe 25 inches in the ground, with mound of rock, with a 3 inch Brass Cap stamped:

T31S R2W
C 1/4 S22
RLS 536 1975

BEARING TREES:

A Cedar, 11 inches diameter bears S19°E. 16.2 feet scribed C 1/4 S22 (BT) with brass washer stamped LS 536 nailed at BT. Blaze

A white Fir 7 inches diameter bears S.78°W. 13.1 feet with brass washer stamped LS 536 nailed at BT Blaze.

NOTE: Both trees have a 6 inch red band painted around trees. CORNER lies in edge of fir and Cedar thicket. Corner bears N.51°W. 196. feet from NorthWest corner of partially collapsed building, and 3 feet South of old Blaze line.

From Book #2, page #35, Tiller Land Survey #14 - Contract #004610N.

Office of Surveyor County of Douglas
State of Oregon, I hereby certify that the within instrument was filed in this office for record on the 12 day of February
Thomas S. Ingram by Virginia A. Yates
(COUNTY OFFICIAL) (DEPUTY)