


CERTIFIED RECORD OF LAND CORNER MONUMENTATION

History of original corner establishment:

NONE

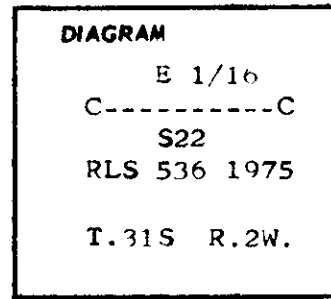

Description of corner evidence found:

NONE



Description of monument and accessories I established to perpetuate the original location of this corner

I set a 30 inch long, 2 1/2 inch diameter galvanized iron pipe, with a mound of stones, 26 inches in ground, with brass cap stamped:

T.31S. R.2W.
E 1/16

BEARING TREES:

C-----C
S22

A Madrona 11 inches in diameter bears S38°E. 19.3 feet scribed C E. 1/16 S22 (BT) with brass washer stamped LS 536 nailed at BT. Blaze

RLS 536 1975

A Fir, 8 1/2 inches in diameter bears N.50°W. 19.0 feet, scribed C E. 1/16 S.22 (BT) with brass washer stamped LS 536 nailed at BT blaze.

NOTE: Both trees have a 6 inch red band painted around tree.

CORNER lies on steep N.E. slope in small Cedar and Madrona thicket, approximately 170 feet East of Ranch Road.

From Book # **2**, page # **34**, Tiller Land Survey #14, Contract #004610N.

Office of *Sherman* County of *Douglas*
 State of *Oregon*, I hereby certify that the within instrument was filed in this office
 for record on the *12* day of *February*
Thomas D. Graham by *Virginia A. Yates*
 (COUNTY OFFICIAL) (DEPUTY)