


CERTIFIED RECORD OF LAND CORNER MONUMENTATION

History of original corner establishment:

None

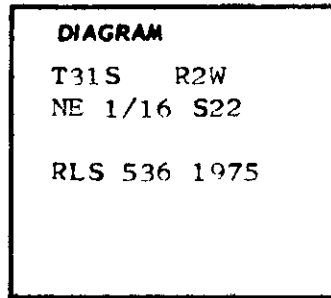

Description of corner evidence found:

NONE



Description of monument and accessories established to perpetuate the original location of this corner

I set a 30 inch long, 2 1/2 inch diameter galvanized iron pipe, in mound of stone, 26 inches in ground with 3 inch Brass Cap stamped:

T31S R2W
NE 1/16
RLS 536 1975

BEARING TREES:

A Fir, 8 inch diameter bears S43°E. 7.0 feet scribed N.E. 1/16 S22 (BT) with Brass washer stamped LS 536 nailed at BT Blaze.

A Fir 8 inch diameter bears S.80°W. 19.9 feet scribed N.E. 1/16 S22 (BT) with brass washer stamped LS 536 nailed at BT Blaze.

NOTE: Both trees have a 6 inch red band painted around trees.

CORNER lies on a South-West slope approximately 80. feet North from North and East Timber Line Corner.

From Book # 2 , page# 33, Tiller Land Survey # 14 Contract #004610N.

Office of *Surveyor* County of *Clatsop*
State of *Oregon*, I hereby certify that the within instrument was filed in this office for record on the *102* day of *February*.
Thomas P. Agnew by *Virginia A. Yates*
(COUNTY OFFICIAL) (DEPUTY)