


CERTIFIED RECORD OF LAND CORNER MONUMENTATION

History of original corner establishment:

NONE

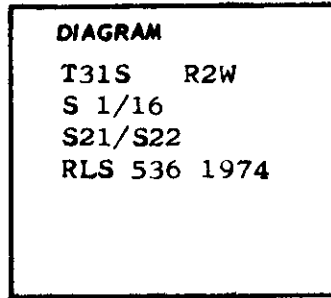

Description of corner evidence found:

NONE



Description of monument and accessories I established to perpetuate the original location of this corner

I set a 30 inch long 2 1/2 inch diameter galvanized iron pipe 26 inches in the ground, in a mound of stones, with a 3 inch brass cap stamped:

BEARING TREES

A 8 inch white Fir bears S40°W 15.8 feet scribed S 1/16 S21 (BT) Brass washer marked LS 536 nailed at BT. Blaze

A 11 inch Cedar bears N26 1/2°E. 59.8 feet scribed S 1/16 S22 (BT) Brass washer marked LS 536 nailed at BT. Blaze

T31S R2W  
S 1/16  
S21/S22  
RLS 536 1974

NOTE: Both trees have a 6 inch red band painted around tree.

CORNER lies on East slope approximately 175 feet West of Road next to North-South timber line, approximately 20 feet South of small spring.

From Book #2, page #31, Tiller Land Survey #14, Contract #004610N.

Office of Surveyor County of DeScha  
State of Oregon, I hereby certify that the within instrument was filed in this office for record on the 102 day of February  
Glenn S. Baughman by Virginia A. Yates  
(COUNTY OFFICIAL) (DEPUTY)