

CERTIFIED RECORD OF LAND CORNER MONUMENTATION

History of original corner establishment:


NONE

DIAGRAM
T31S R2W
SW 1/16 S22

RLS 536 1975

Description of corner evidence found:

NONE

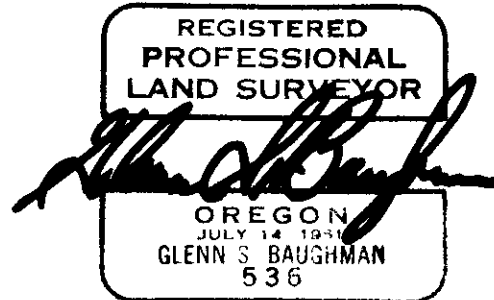

Description of monument and accessories I established to perpetuate the original location of this corner

I set a 30 inch long, 2 1/2 inch diameter galvanized iron pipe in a mound of stones, 26 inches in the ground, with brass cap stamped:

BEARING TREES:

A Cedar 7 inch diameter bears N.43°E. 7.9 feet scribed SW 1/16 S22 (BT) with brass washer stamped LS 536 nailed at BT Blaze.

A Cedar 8 inch diameter bears N.35°W. 21.1 feet scribed SW 1/16 S22 (BT) with brass washer stamped LS 536 nailed at BT Blaze.

NOTE: Both trees have a 6 inch red band painted around tree.

Corner lies on gradual NorthEast slope, approximately 85 feet south of a small draw and about 400 feet west of Drew Creek.

From Book **2** Page **30** Tiller Land Survey Contract No. 004610N

T31S R2W
SW 1/16 S22
RLS 536 1975

Office of *Surveyor* County of *Deschutes*
State of *Oregon* .., I hereby certify that the within instrument was filed in this office
for record on the *12* day of *February* ..
Thomas P. Agnam by *Virginia A. Yates* ..
(COUNTY OFFICIAL) (DEPUTY)