


CERTIFIED RECORD OF LAND CORNER MONUMENTATION

History of original corner establishment:

NONE

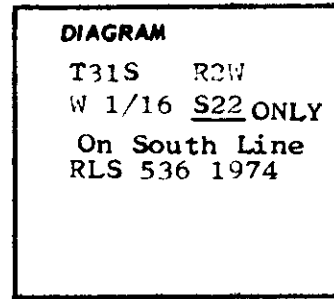

Description of corner evidence found:

Found 1/2 inch iron pipe set 16 inches above ground with no Bearing Trees.

No record of this Corner.



Description of monument and accessories I established to perpetuate the original location of this corner

I set a 30 inch long, 2 1/2 inch diameter galvanized iron pipe in mound of stones, 26 inches in the ground, with brass cap stamped:

BEARING TREES:

A Cedar, 8 inch diameter bears N.26°E. 28.1 feet scribed W. 1/16 S22 (BT) with brass washer stamped LS 536 nailed at BT Blaze.

A Cedar 9 inch diameter bears N.77°W. 17.4 feet, scribed W. 1/16 S22 (BT) with brass washer stamped: LS 536 nailed at BT Blaze.

NOTE: Both trees have a 6 inch red band painted around tree.

CORNER falls on gradual East slope approximately 450 feet West from Drew Creek; also East 30 feet from timber line.

From Book **5** Page **29** Tiller Land Survey No. 14 Contract No. 004610N

Office of Surveyor County of Douglas
State of Oregon, I hereby certify that the within instrument was filed in this office
for record on the 102 day of February ..
Franklin S. Baughman by Virginia A. Yates
(COUNTY OFFICIAL) (DEPUTY)