


CERTIFIED RECORD OF LAND CORNER MONUMENTATION

History of original corner establishment:


NONE

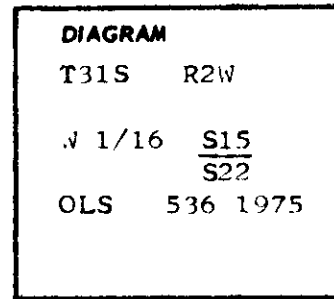

Description of corner evidence found:

Found unidentified 1/2 Inch iron pipe, in mound of stones.
It lies N.18°43'W. 16.28 feet from our corner.

No bearing trees identified.

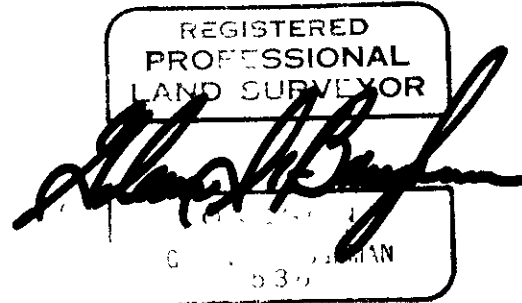

Description of monument and accessories I established to perpetuate the original location of this corner

I set a 30 inch long 2 1/2 inch diameter galvanized pipe 26 inches in the ground, in a mound of stones, with a 3 inch Brass Cap stamped:

T31S R2W

BEARING TREES:

W 1/16 S15

A 10 inch Fir bears N.56°E. 4.8 feet, scribed W. 1/16 S15 BT
With a brass washer stamped Ls 536 nailed at BT. Blaze

S22

OLS 536 1975

A 7 inch Madrona bears S45°W. 16.8 feet scribed W 1/16 S22 BT
with a brass washer stamped LS 536 nailed at BT. Blaze

NOTE: Both trees have a 6 inch red band painted around the tree.

From book #2, page #40, Tiller Land Survey #14, Contract #004610N.

Office of *Surveyor* County of *Douglas*

State of *Oregon*, I hereby certify that the within instrument was filed in this office
for record on the *10th* day of *February*

Thomas D. Ingram by *Virginia C. Yates*

(COUNTY OFFICIAL) (DEPUTY)