


CERTIFIED RECORD OF LAND CORNER MONUMENTATION

History of original corner establishment:

NONE

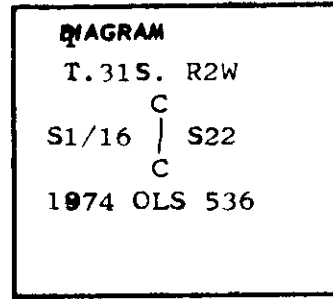

Description of corner evidence found:

NONE



Description of monument and accessories established to perpetuate the original location of this corner

I set a 30 inch long, 2 1/2 inch diameter galvanized iron pipe 26 inches in the ground, in a mound of stones, with a 3 inch brass cap marked:

Bearing Trees:

A Cedar, 8" inches diameter bears S.43°W. 17.3 feet scribed CSI/16 S22 (BT) with a brass washer stamped LS 536 nailed at BT. Blaze

T31S	R2W	
	C	
S1/16		S22
	C	
1974 OLS 536		

A Cedar, 8 inches diameter bears S 81°E. 6.2 feet scribed CSI/16 S22 (BT) with a brass washer stamped LS 536 nailed at B.T. Blaze

NOTE: Both trees have a 6 inch red band painted around tree.

Corner lies approximately 17 feet South of East-West fence line.

From Book #2, page 26, Tiller Land Survey #14- Contract #004610N.

Office of Surveyor ..... County of Douglas .....

State of Oregon ....., I hereby certify that the within instrument was filed in this office for record on the 12 day of February .....

Francis P. Ferguson by Virginia A. Yatta .....

(COUNTY OFFICIAL) (DEPUTY)