


CERTIFIED RECORD OF LAND CORNER MONUMENTATION

History of original corner establishment:

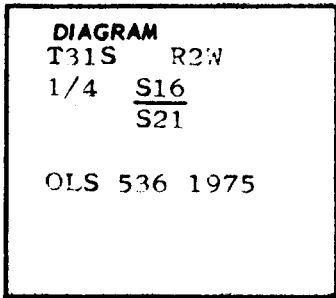

Original Survey record states:

Set 1/4 Section Post at 40 chains, from which bears
an Oak 18 inches in diameter S40°W 45 lks.
an Oak 12 inches in diameter N60°W 8 lks.
Summit of very high ridge course North and South.

Description of corner evidence found:

NONE

Searched for but could not find any evidence of old Corner or original bearing trees.



Description of monument and accessories I established to perpetuate the original location of this corner

I set a 30 inch long, 2 1/2 inch diameter galvanized iron pipe 26" in the ground in mound of stone, with 3 inch brass cap stamped:

T31S R2W
1/4 S16
S21
OLS 536 1975

BEARING TREES:

A Pine, 13 inch diameter bears N22°W 47.5 feet, scribed 1/4 S16 (BT) with brass washer stamped LS 536 nailed at BT. Blaze

A Pine 10 inch diameter bears S.59°W. 36.2 feet, scribed 1/4 S21 (BT) with brass washer stamped LS 536 Nailed at BT. Blaze

NOTE: Both trees have a 6 inch red band painted around tree.

CORNER lies on gentle West slope approximately 30 feet West of North-South ridge and 30 feet East of North-South timber line.

From Book # 1 , page # 20 , Tiller Land Survey, Contract #004610N. (Extra work)

Office of Surveyor County of Douglas
State of Oregon, I hereby certify that the within instrument was filed in this office for record on the 13 day of February
Francis L. Eggen by Virginia P. Yates
(COUNTY OFFICIAL) (DEPUTY)

FIRST